


GENERAL NOTES

- HOLES - BOLTS
- CSK HOLES N/S F/S
- DENOTES ERECTION MARK LOCATION - FOR ORIENTATION
- 1. ALL DIMS IN MILLIMETRES UNO
- 2. RADIUS ALL NOTCHES
- 3. GENERAL TOLERANCE IS 0 MM UNO
- 4. REMOVE ALL BURRS AND SHARP EDGES
- 5. ALL STEEL GRADE S275
- 6. ALL FITTINGS GRADE S275
- 7. ALL BOLTS GRADE 8.8

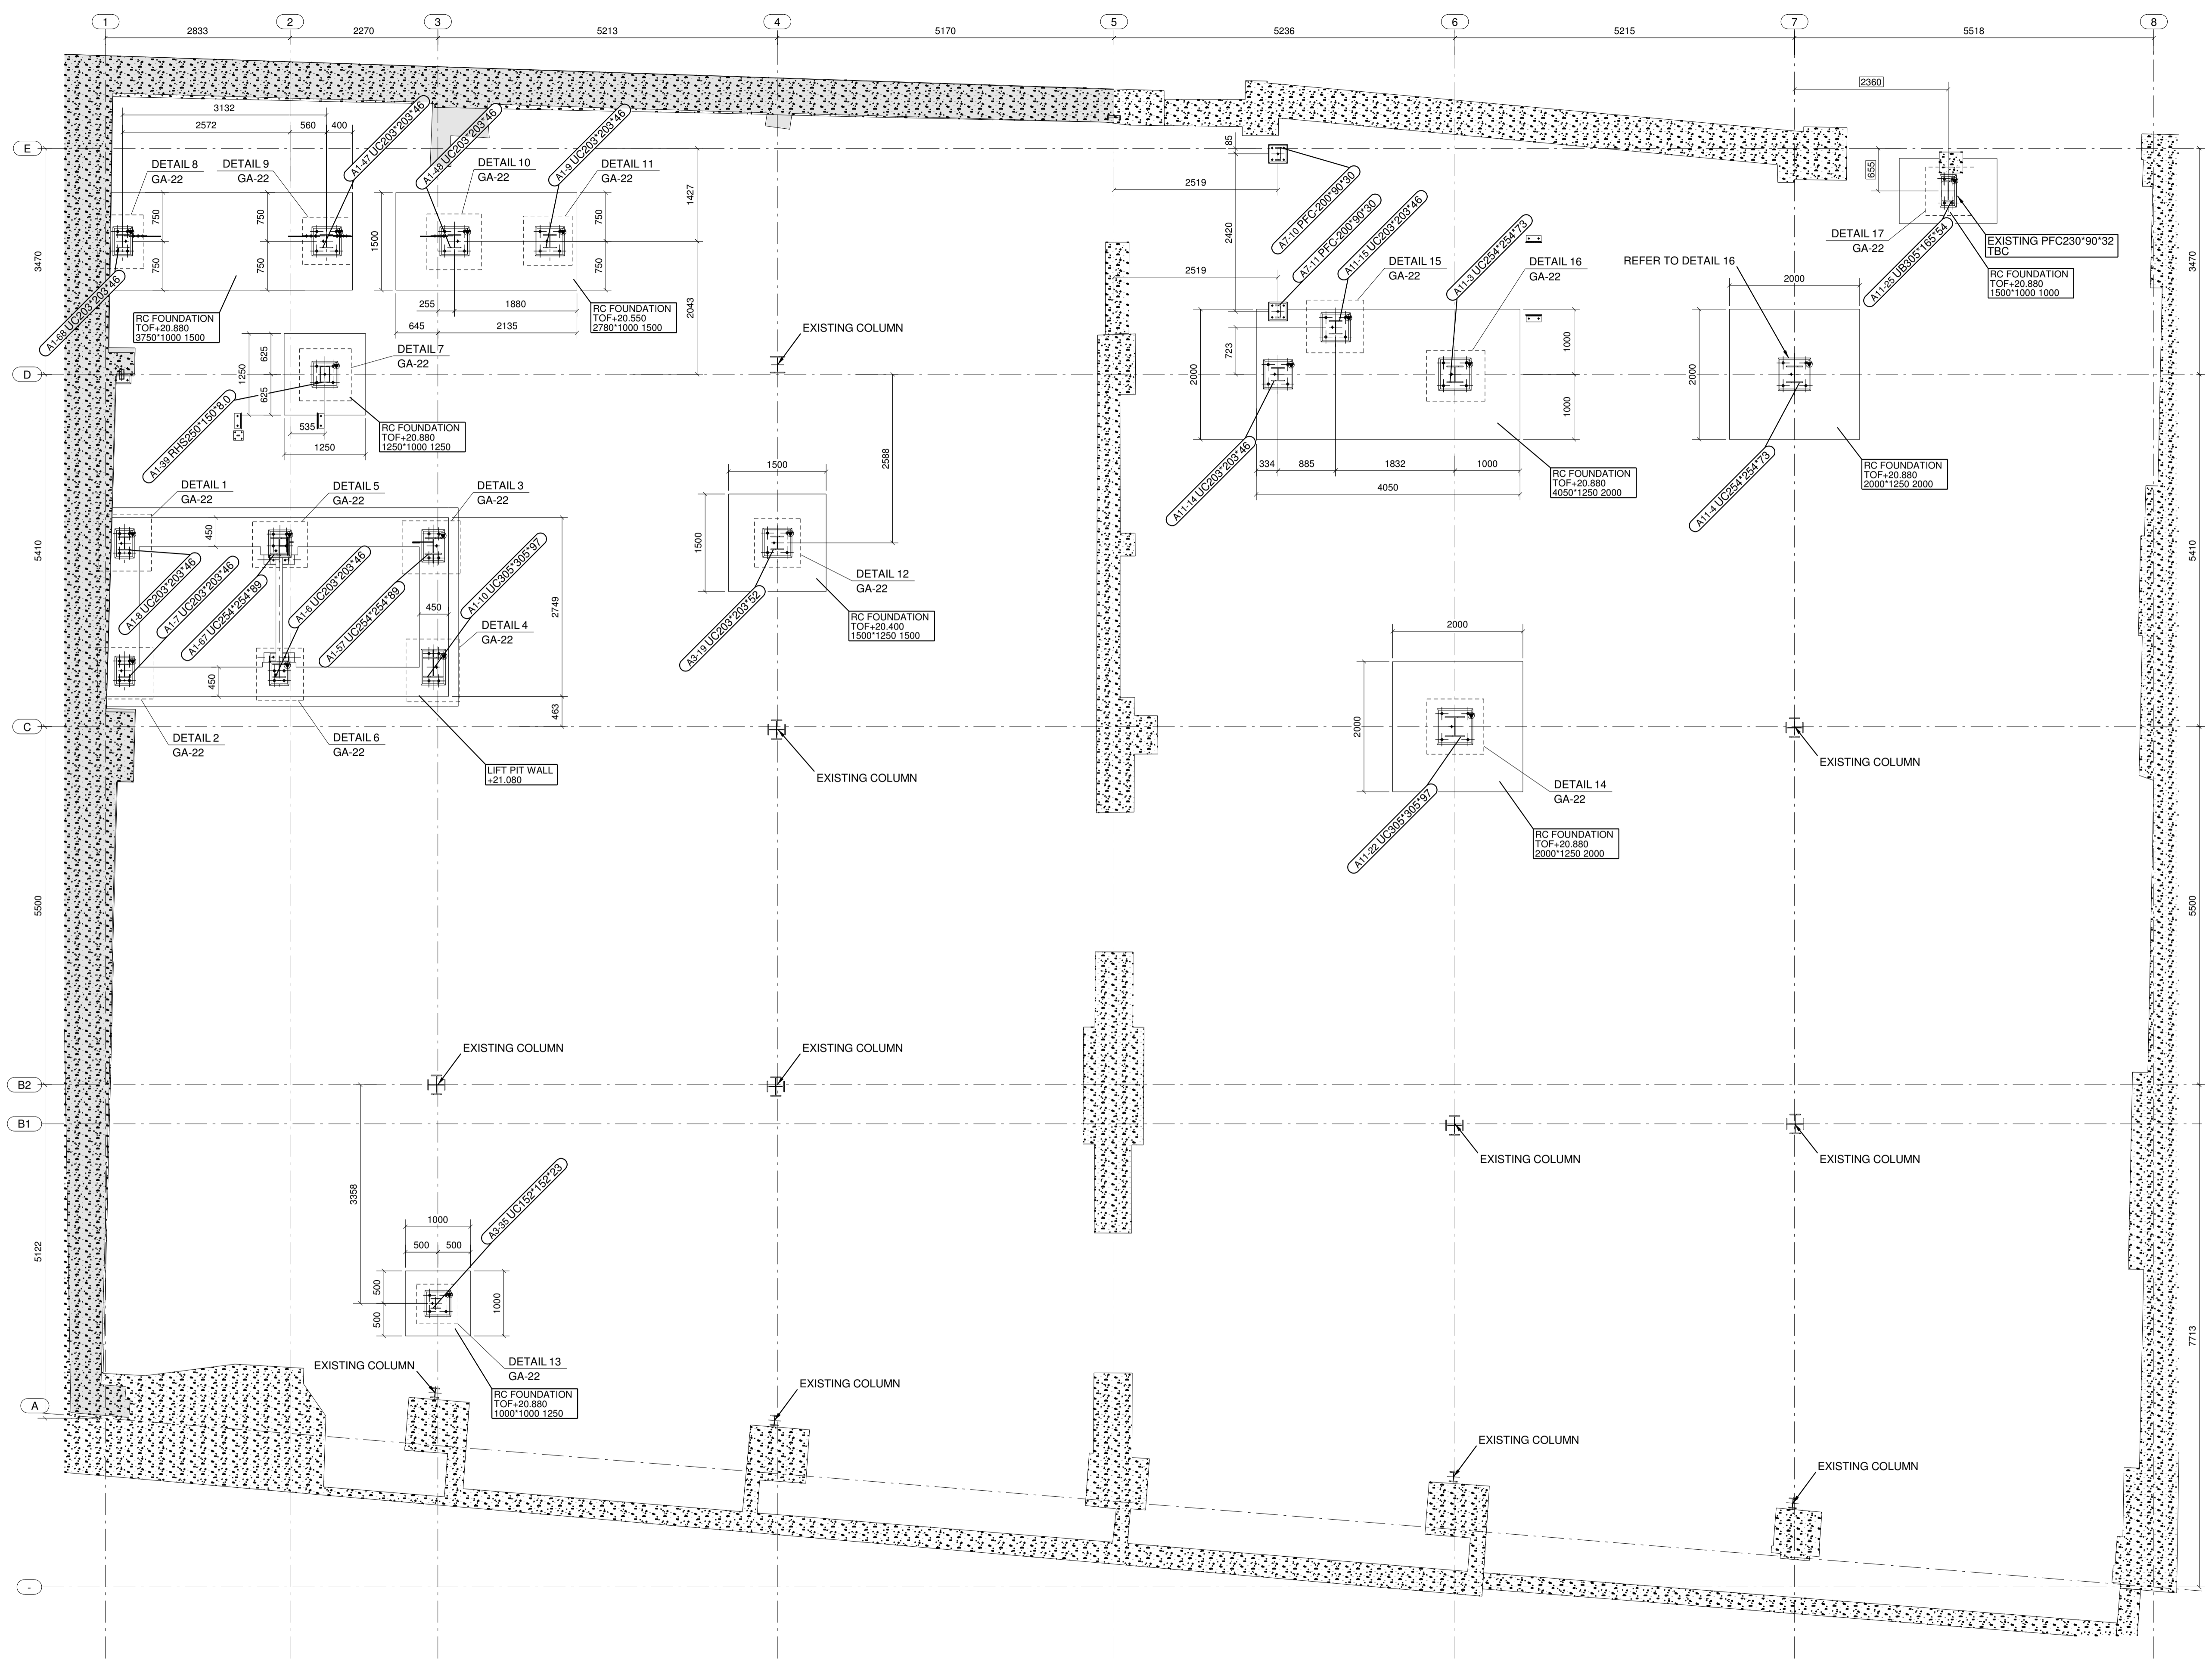

Plan SSL+21.080
1:50

REV. MARK	REVISION DESCRIPTION	REV. DATE
4	RC FOUNDATION UPDATED GL 7.8/E	13.04.11
3	BASE PLATE DETAIL 17 REPOSITIONED	06.04.11
2	BASE PLATE DETAIL 17 ADDED	21.03.11
1	PART MARKS ADDED	16.03.11
0	FOR APPROVAL	04.02.11

A C D
Architectural Corporate Drafting Ltd
9 Millhouse Close
Whittington
Oswestry
Shropshire
SY11 4NA
Mobile: 07711 093 578
Tel/Fax: 01691 654451
Email: info@a-c-d.co.uk

CLIENT
SKANSKA
PROJECT DESCRIPTION
1-5 POLAND STREET
SITE ADDRESS
LONDON
DRAWING TITLE
**STRUCTURAL MAIN BUILDING
FOUNDATION PLAN**
GENERAL ARRANGEMENT

SCALE
1:50
DRAWN BY
Andy Curran
CHECKED BY
A. G
CONTACT NAME
Andrew Gamblen
DRAWING CREATION DATE
04.02.2011

Material to BS4360. Grade - See Spec	ACD REF No: A.C-D-076-01	CONTRACT No: C/10751	REVISION 4
Surface Finish / Prep: See Spec	Welds:- 6mm F.W. Full profile U.S.O.		
AS BUILT DRG			GA-01