



1. ALL DIMS IN MILLIMETRES UNO
2. RADIUS ALL NOTCHES
3. GENERAL TOLERANCE IS 0.5 MM UNO
4. REMOVE ALL BURRS AND SHARP EDGES
5. ALL STEEL GRADE S275
6. ALL FITTINGS GRADE S275
7. ALL BOLTS GRADE 8.8

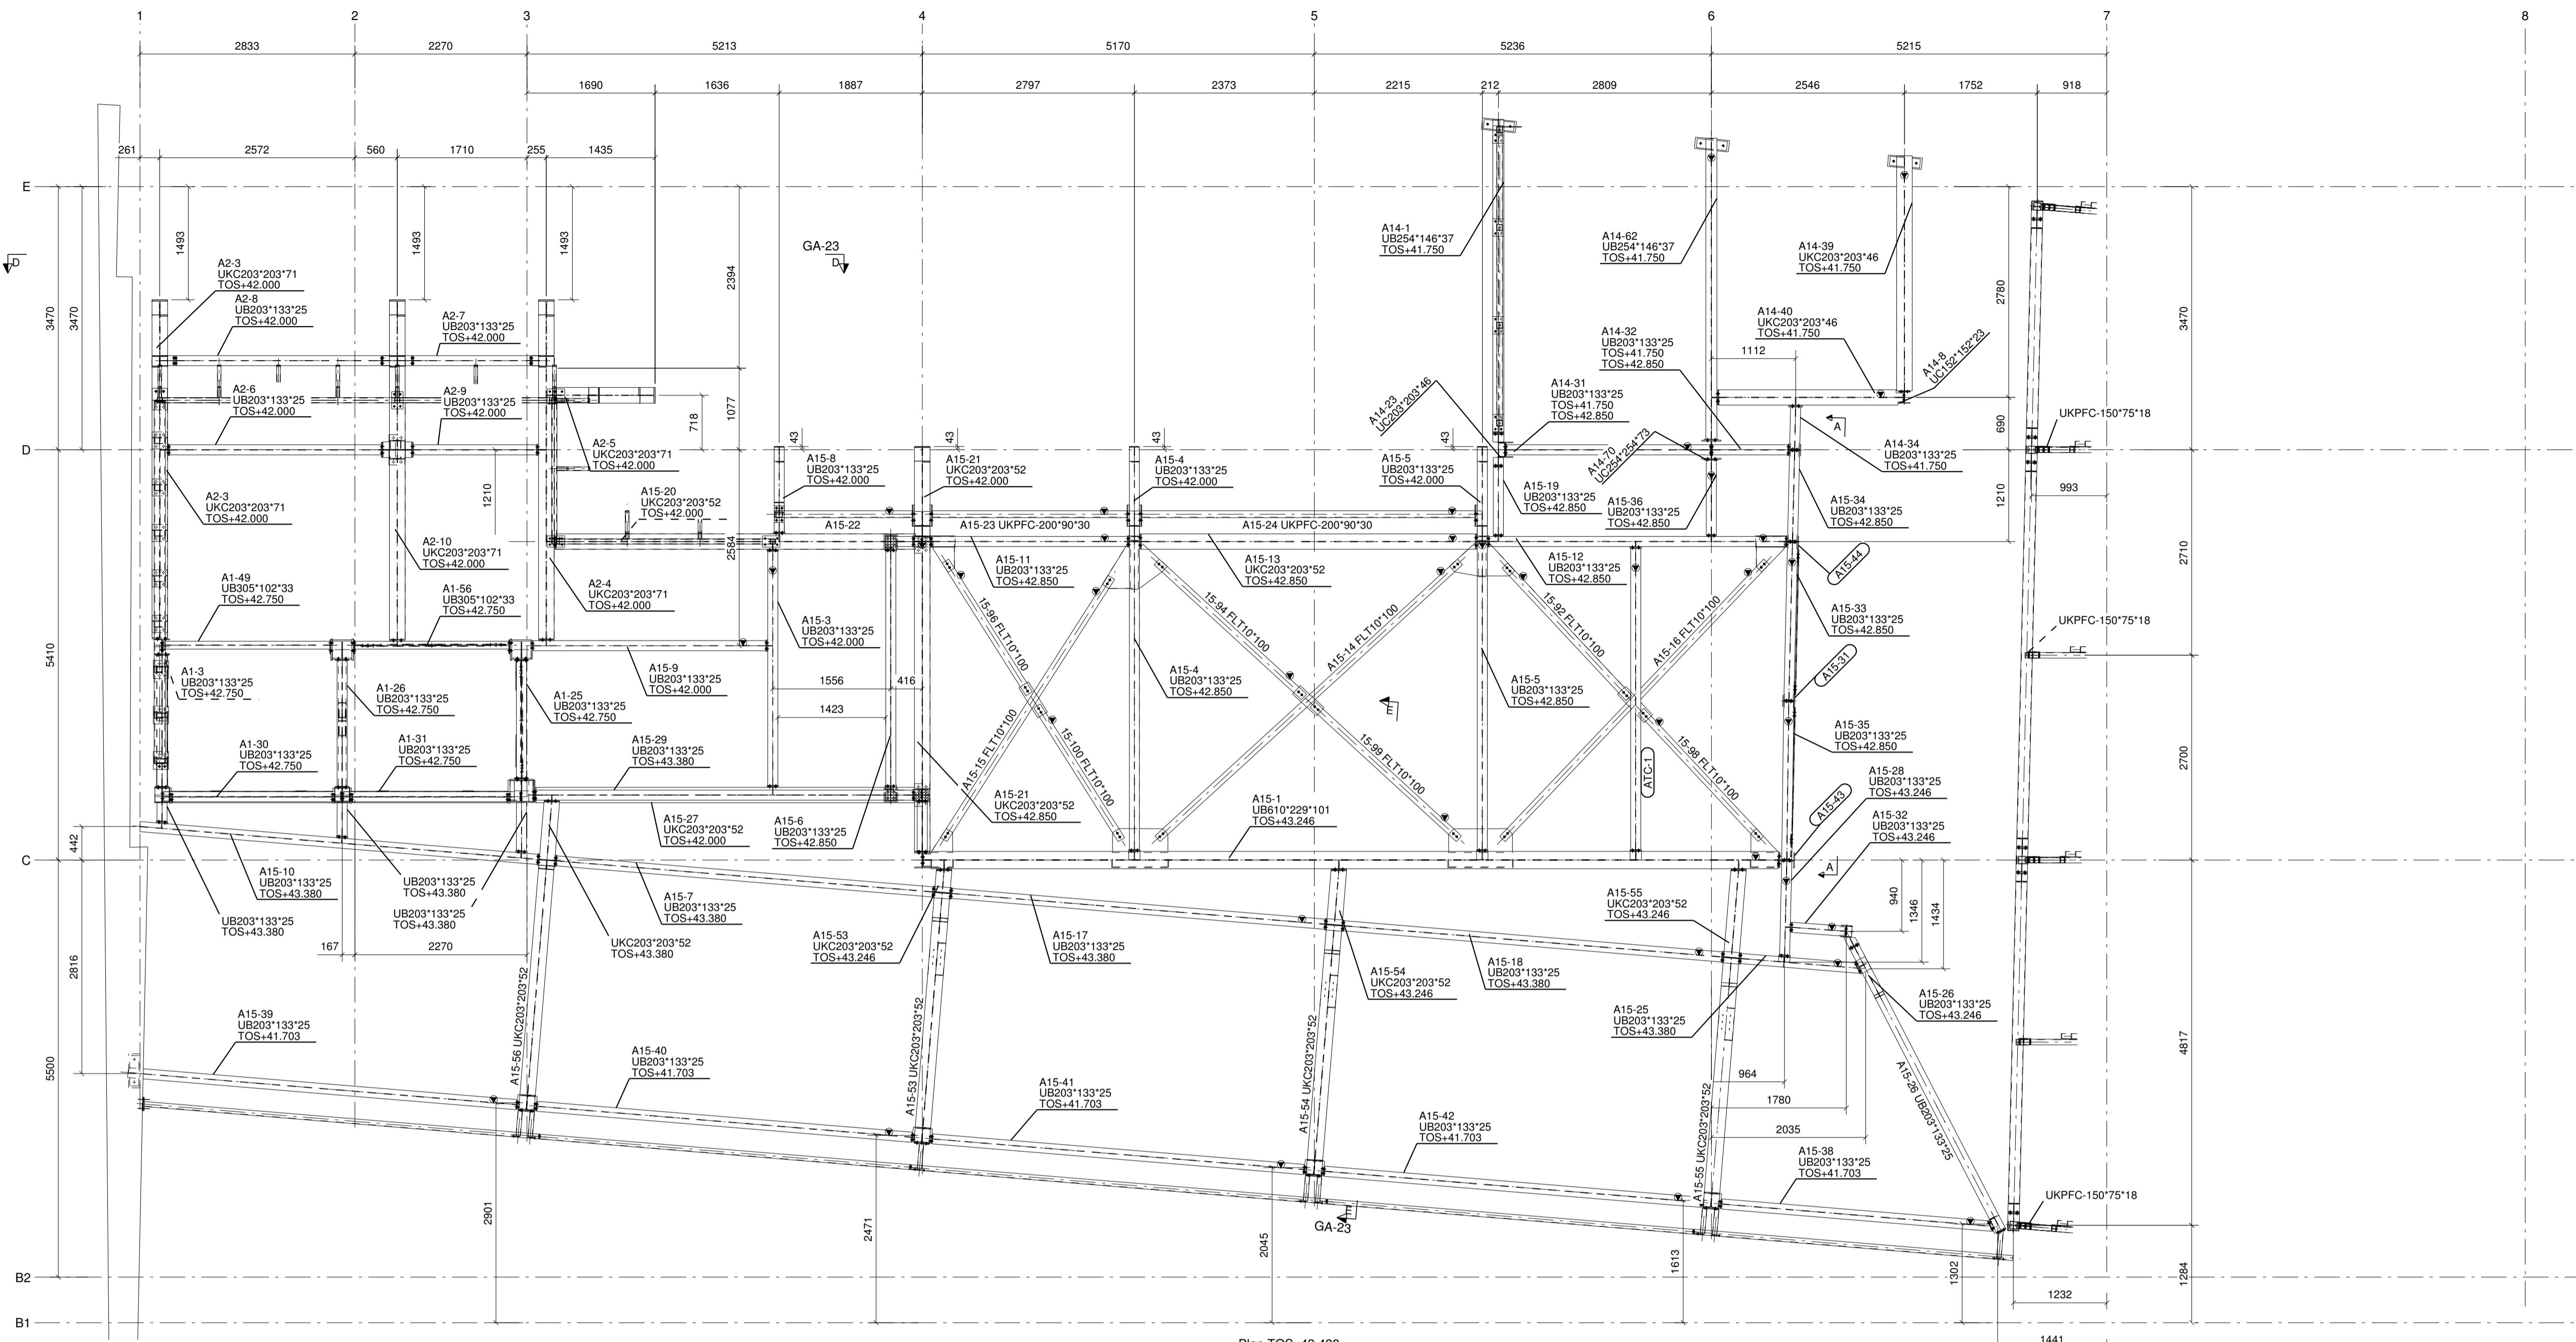

Plan TOS+43.430
1:50

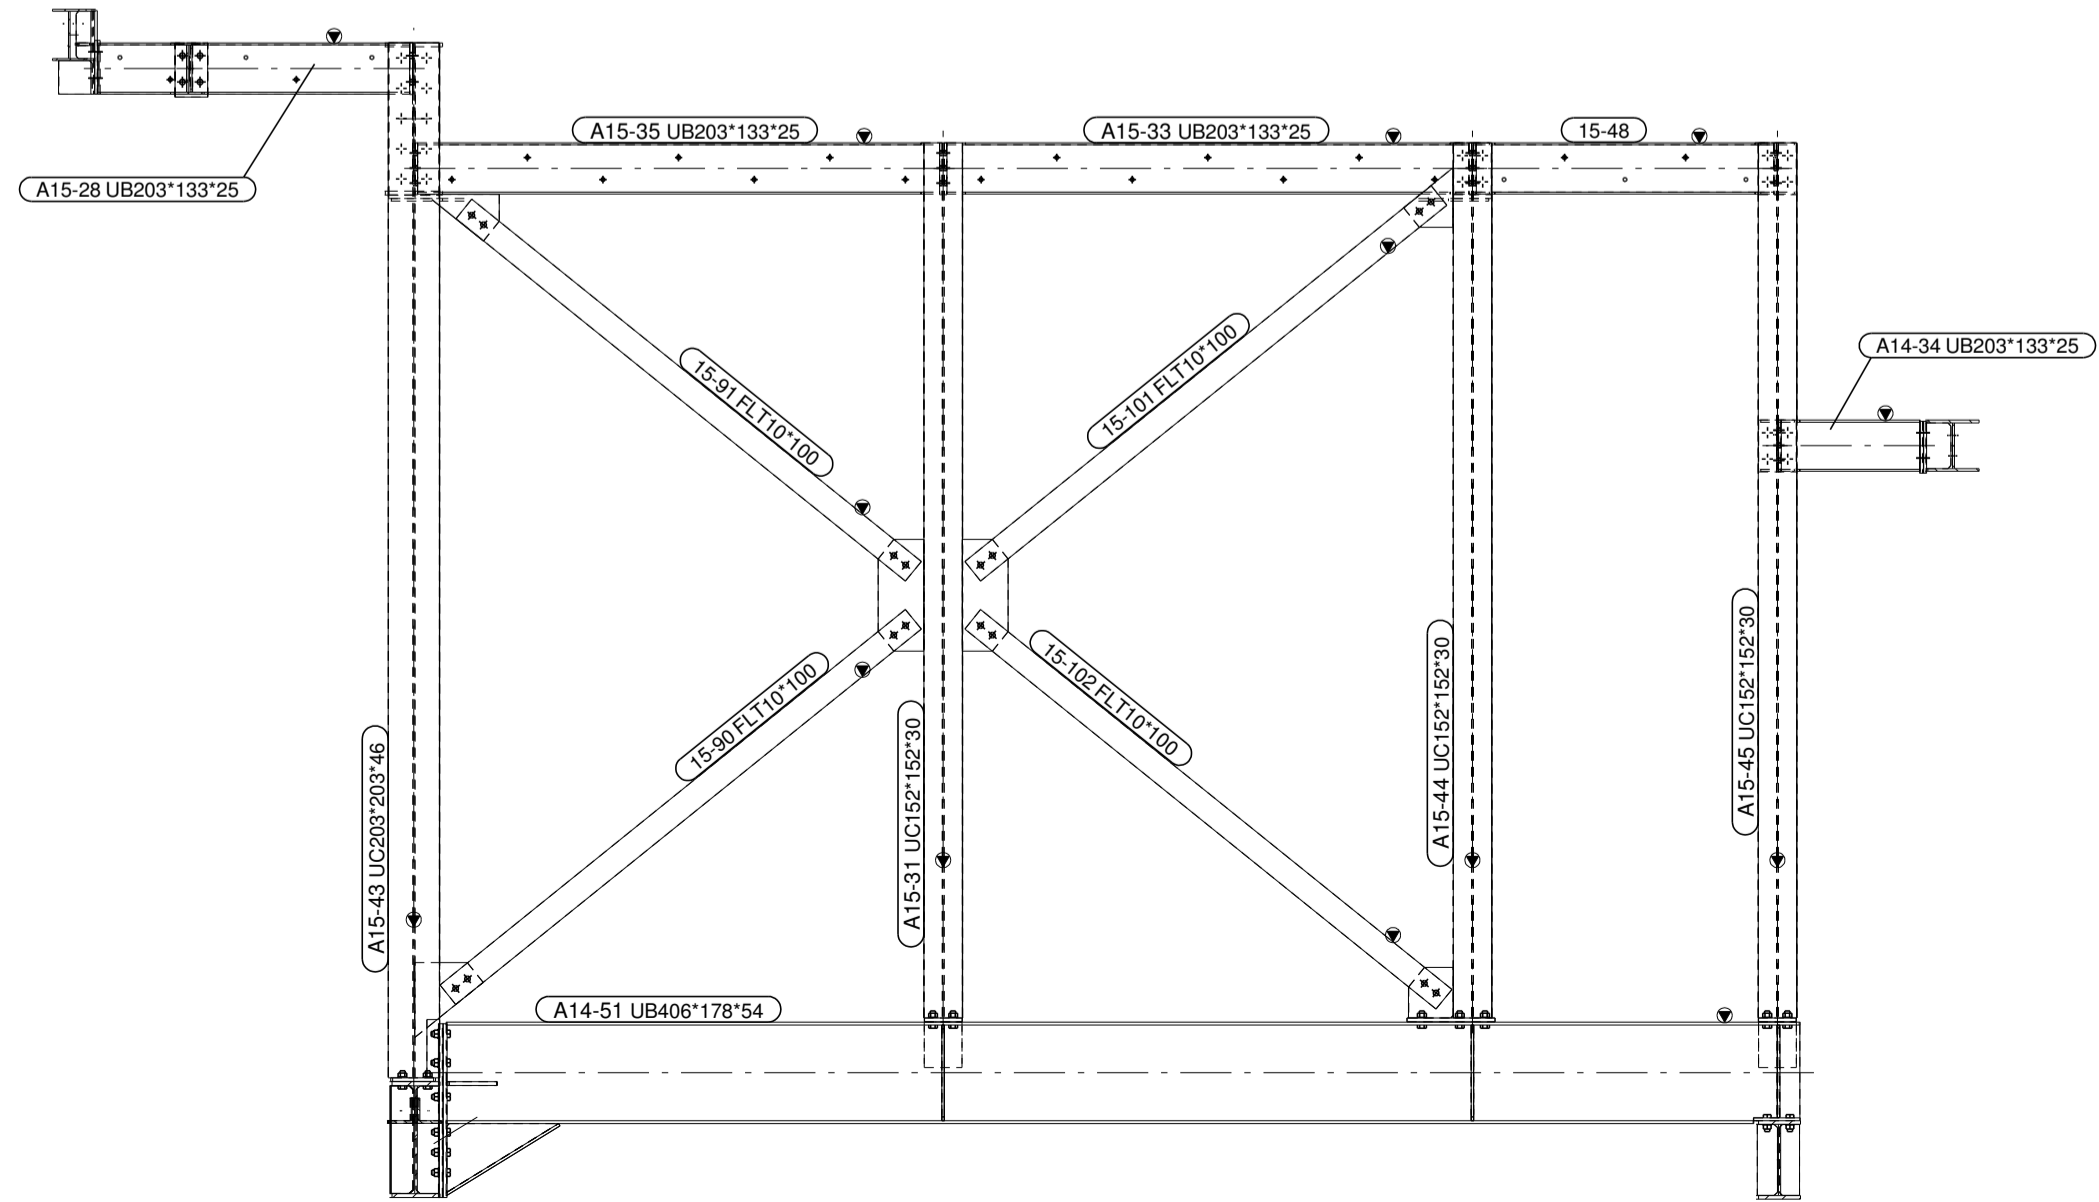

A-A
1:30

REV. MARK	REVISION DESCRIPTION	REV. DATE
4	DIMS UPDATED GRD 3D	27.06.11
3	PART MARKS ADDED	06.06.11
2	PART MARKS ADDED	25.05.11
1	PART MARKS ADDED	16.03.11
0	FOR APPROVAL	25.02.11

A C D
Architectural Corporate Drafting Ltd
9 Mailhouse Close
Whittington
Oswestry Mobile: 07711 093 578
Shropshire Tel/Fax: 01691 654451
SY11 4NA Email: info@a-c-d.co.uk

CLIENT	SKANSKA
PROJECT DESCRIPTION	1-5 POLAND STREET
SITE ADDRESS	LONDON
DRAWING TITLE	STRUCTURAL MAIN BUILDING ROOF LEVEL PLAN GENERAL ARRANGEMENT
SCALE	1:30 1:50
DRAWN BY	Andy Curran
CHECKED BY	A. G
CONTACT NAME	Andrew Gamblen
DRAWING CREATION DATE	04.02.2011

Material to BS4360. Grade - See Spec	CONTRACT No:	REVISION
Surface Finish / Prep: See Spec	C/10751	4
Welds: 6mm F.W. Full profile U.S.O.		
AS BUILT DRG	GA-07	