


- 1. ALL DIMS IN MILLIMETRES UNO
- 2. RADIUS ALL NOTCHES
- 3. GENERAL TOLERANCE IS 0.5 MM UNO
- 4. REMOVE ALL BURRS AND SHARP EDGES
- 5. ALL STEEL GRADE S275
- 6. ALL FITTINGS GRADE S275
- 7. ALL BOLTS GRADE 8.8

CSK HOLES N/S F/S

● DENOTES ERECTION MARK LOCATION - FOR ORIENTATION

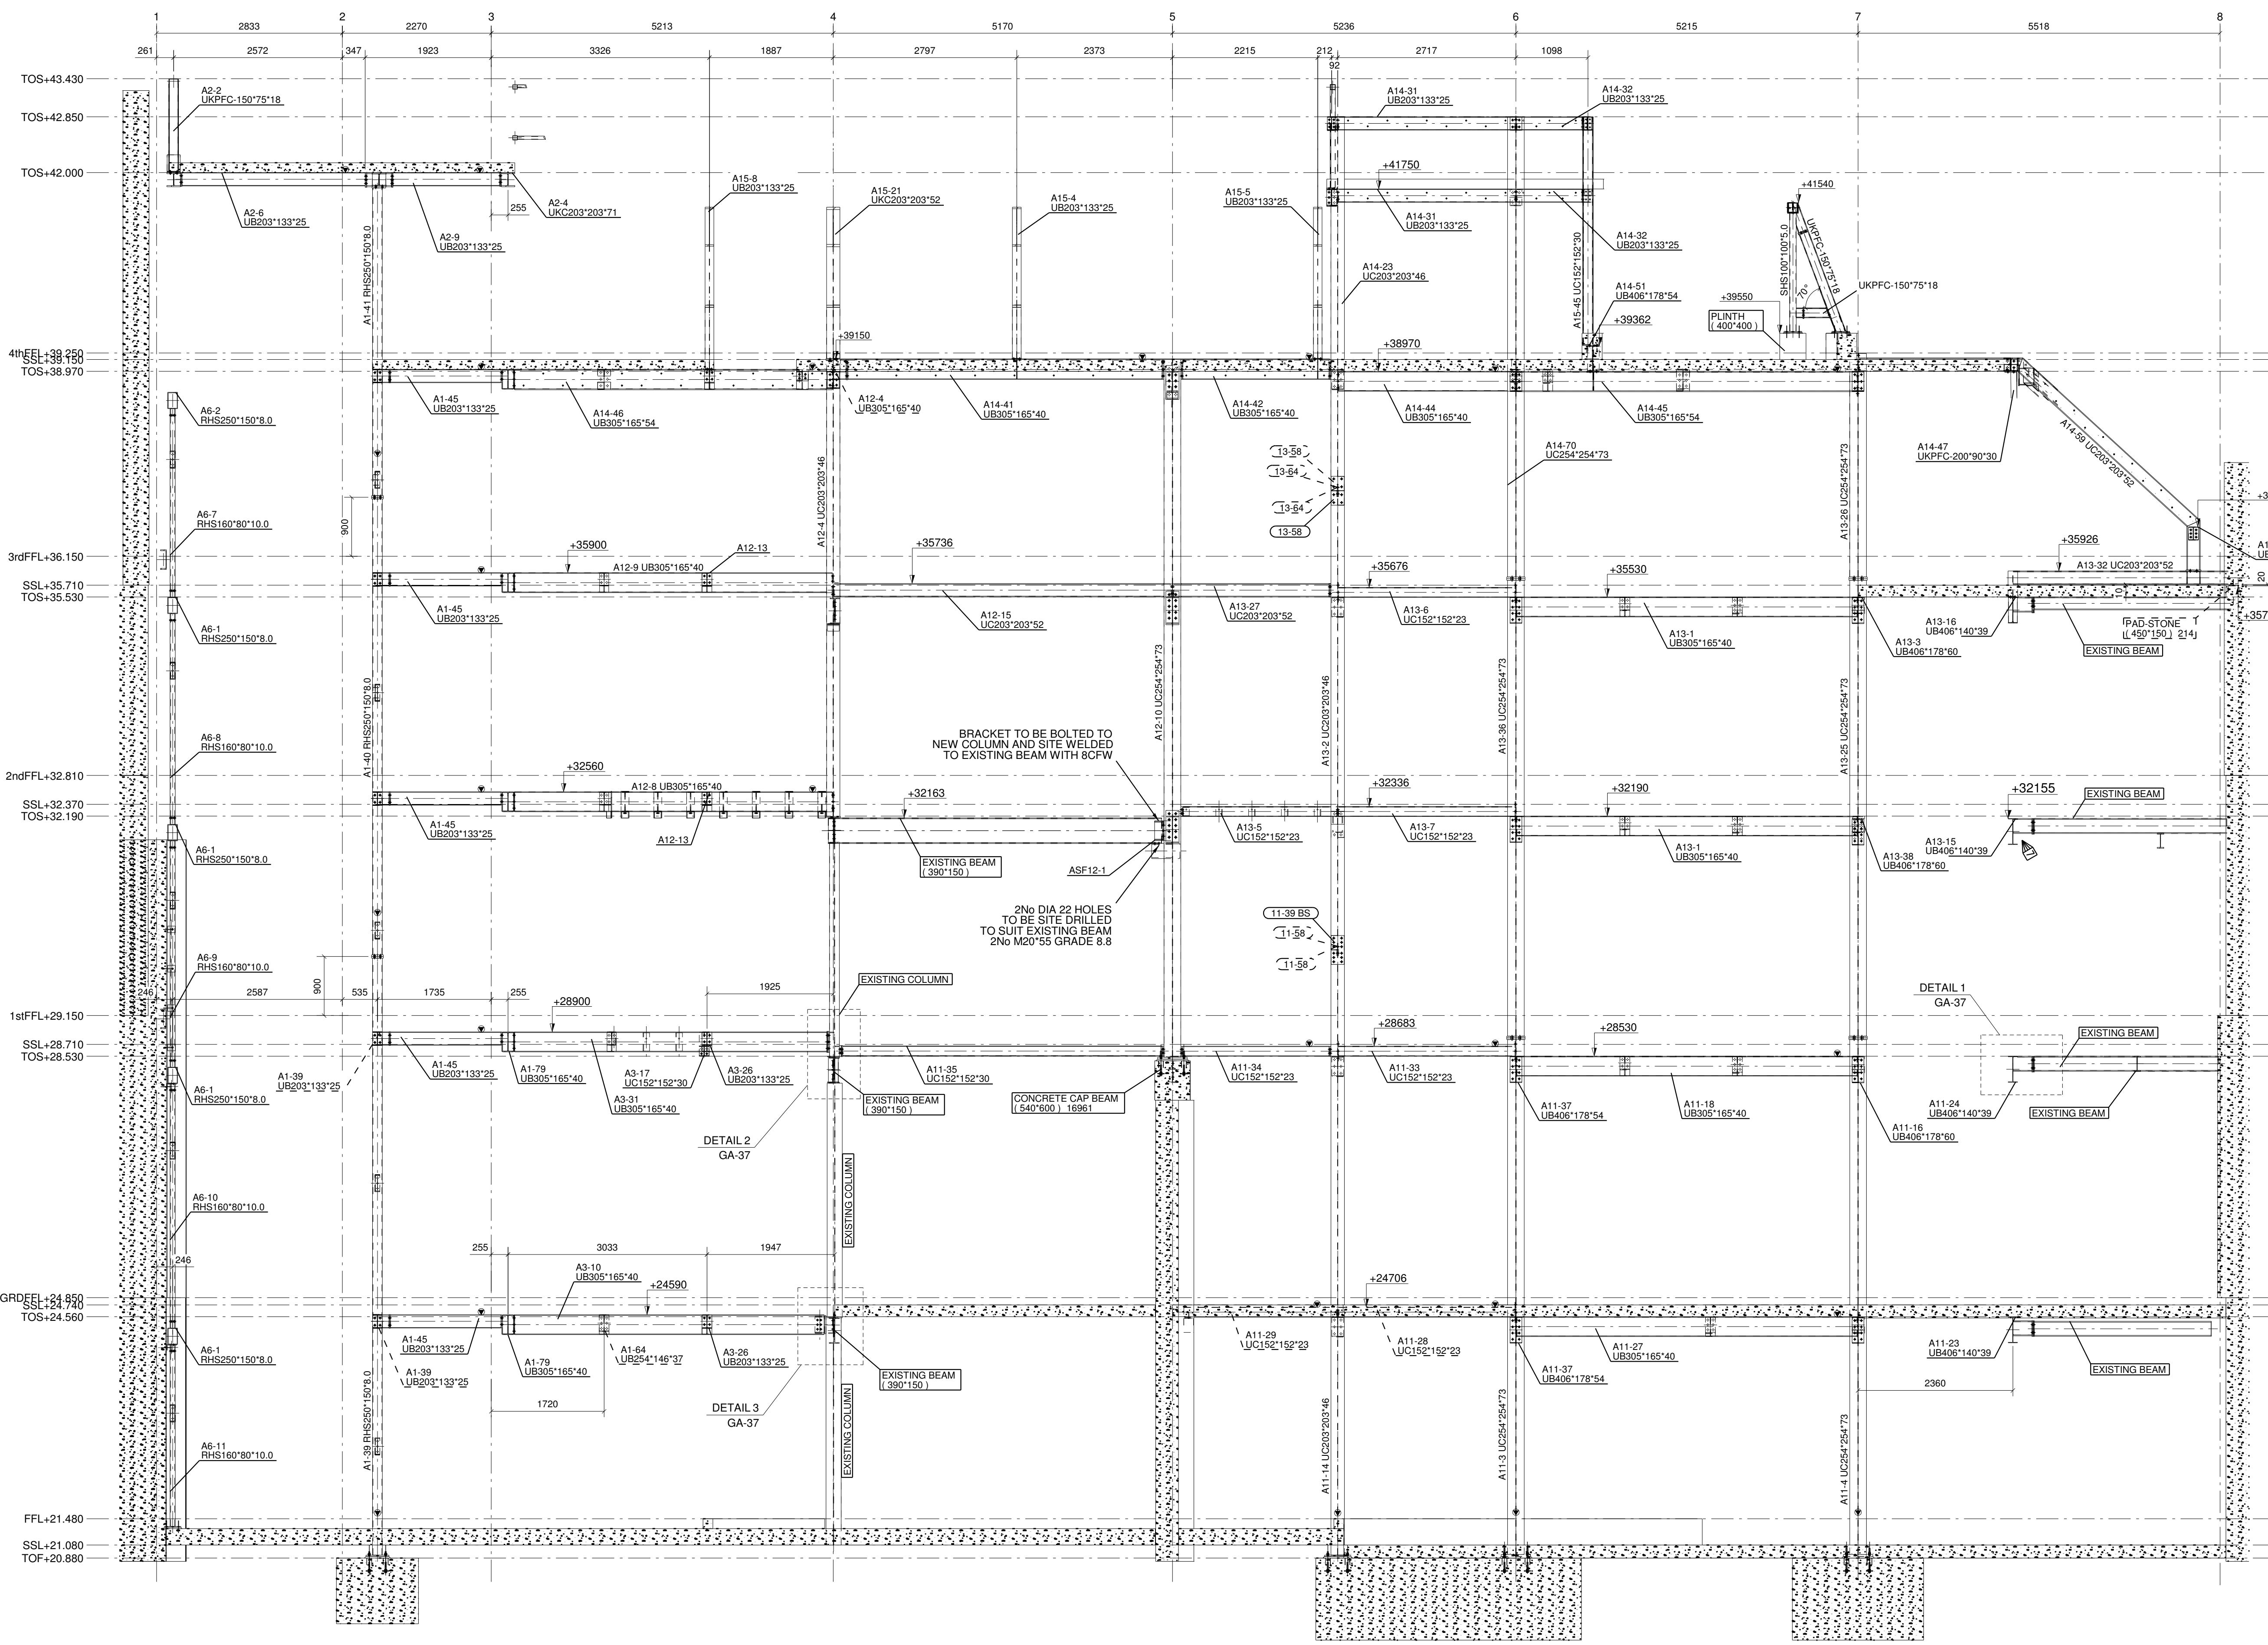

REV. MARK	REVISION DESCRIPTION	REV. DATE
9	PART MARKS ADDED	06.06.11
8	4TH FFL PART MARKS ADDED	25.05.11
7	BEAMS MOVED DOWN 35mm	11.05.11
6	PART MARKS ADDED	08.05.11
5	PART MARKS ADDED	20.04.11
4	PART MARKS ADDED	06.04.11
3	PART MARKS ADDED	16.03.11
2	LVL 4 & ROOF ADDED / FOR APPROVAL	27.02.11
1	LVL 2 & 3 ADDED / FOR APPROVAL	17.02.11
0	FOR APPROVAL	07.02.11



CLIENT: SKANSKA
PROJECT DESCRIPTION: 1-5 POLAND STREET
SITE ADDRESS: LONDON
DRAWING TITLE: STRUCTURAL MAIN BUILDING
GRID D
GENERAL ARRANGEMENT
SCALE: 1:50
DRAWN BY: Andy Curran
CHECKED BY: A. G.
CONTACT NAME: Andrew Gamblen
DRAWING CREATION DATE: 04.02.2011

Material to BS4360. Grade - See Spec	CONTRACT No: C/10751	REVISION: 9
Surface Finish / Prep: See Spec		
Welds: 6mm F.W. Full profile U.S.O.		
AS BUILT DRG	DRAWING No: GA-20	

Grid D
1:50