



GENERAL NOTES


- CSK HOLES N/S
- BOLTS
- F/S
- DENOTES ERECTION MARK LOCATION - FOR ORIENTATION
- 1. ALL DIMS IN MILLIMETRES UNO
- 2. RADIUS ALL NOTCHES
- 3. GENERAL TOLERANCE IS 0 MM UNO
- 4. REMOVE ALL BURRS AND SHARP EDGES
- 5. ALL STEEL GRADE S275
- 6. ALL FITTINGS GRADE S275
- 7. ALL BOLTS GRADE 8.8

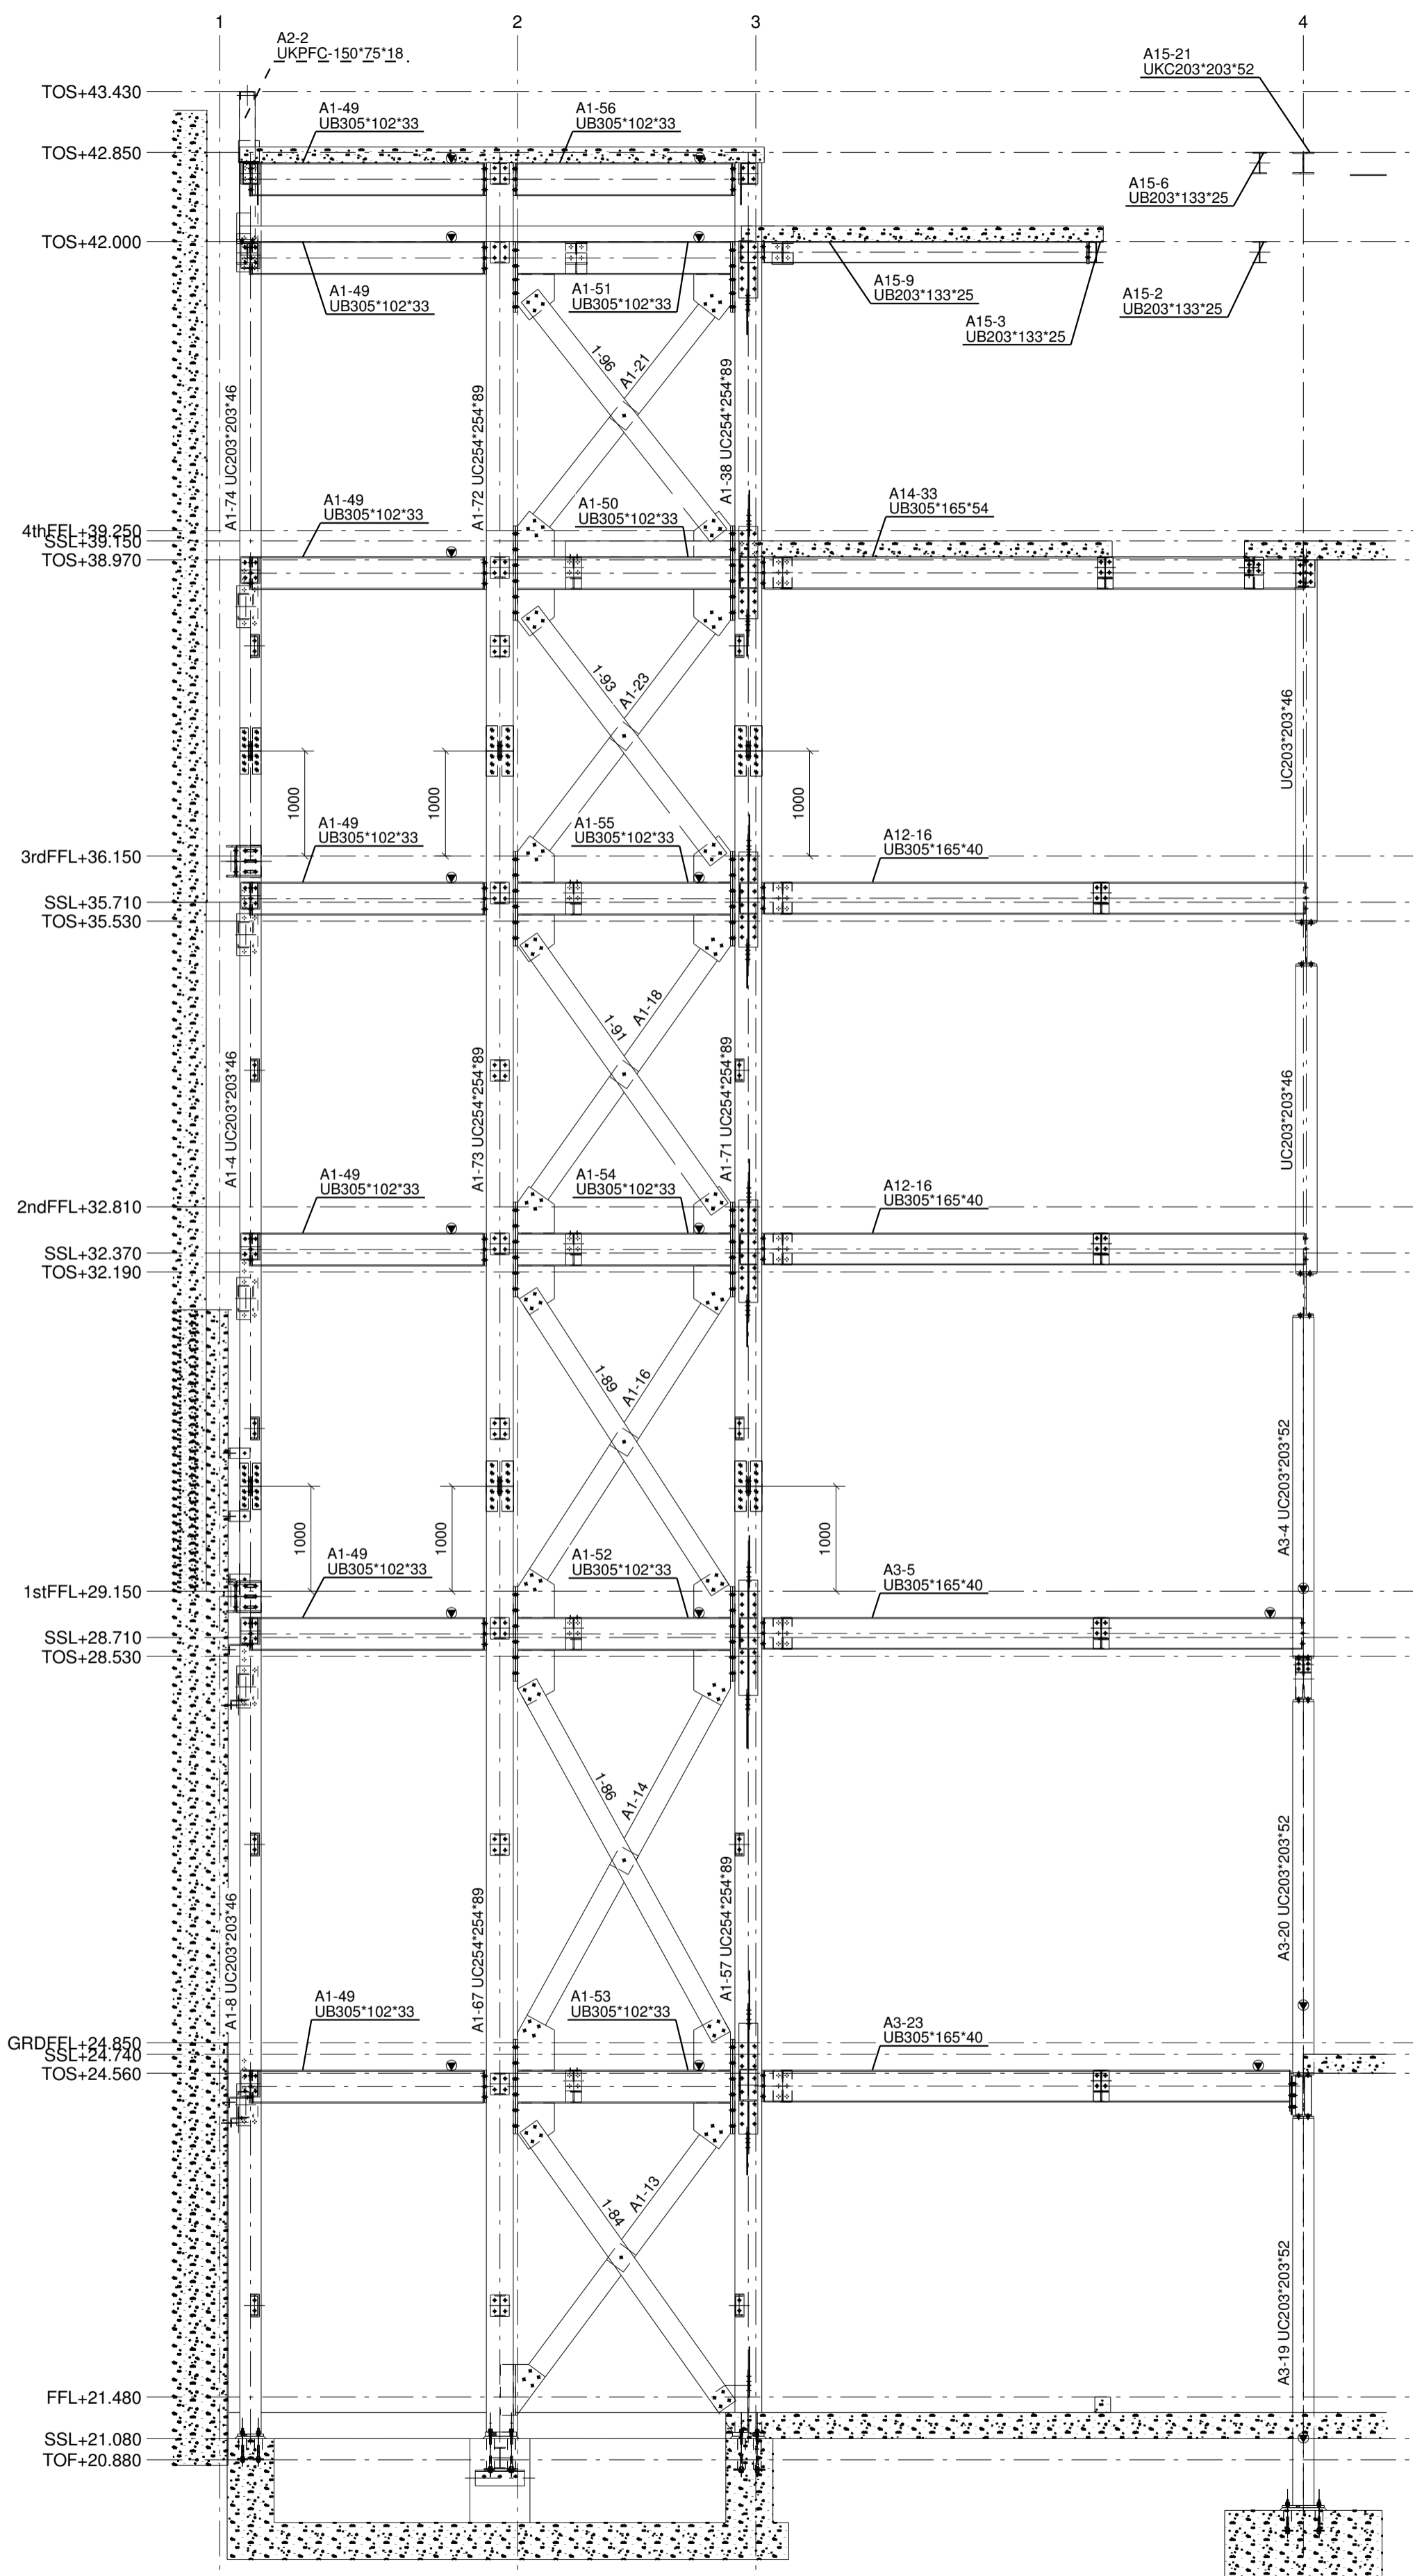


D - D  
GA-06 1:50

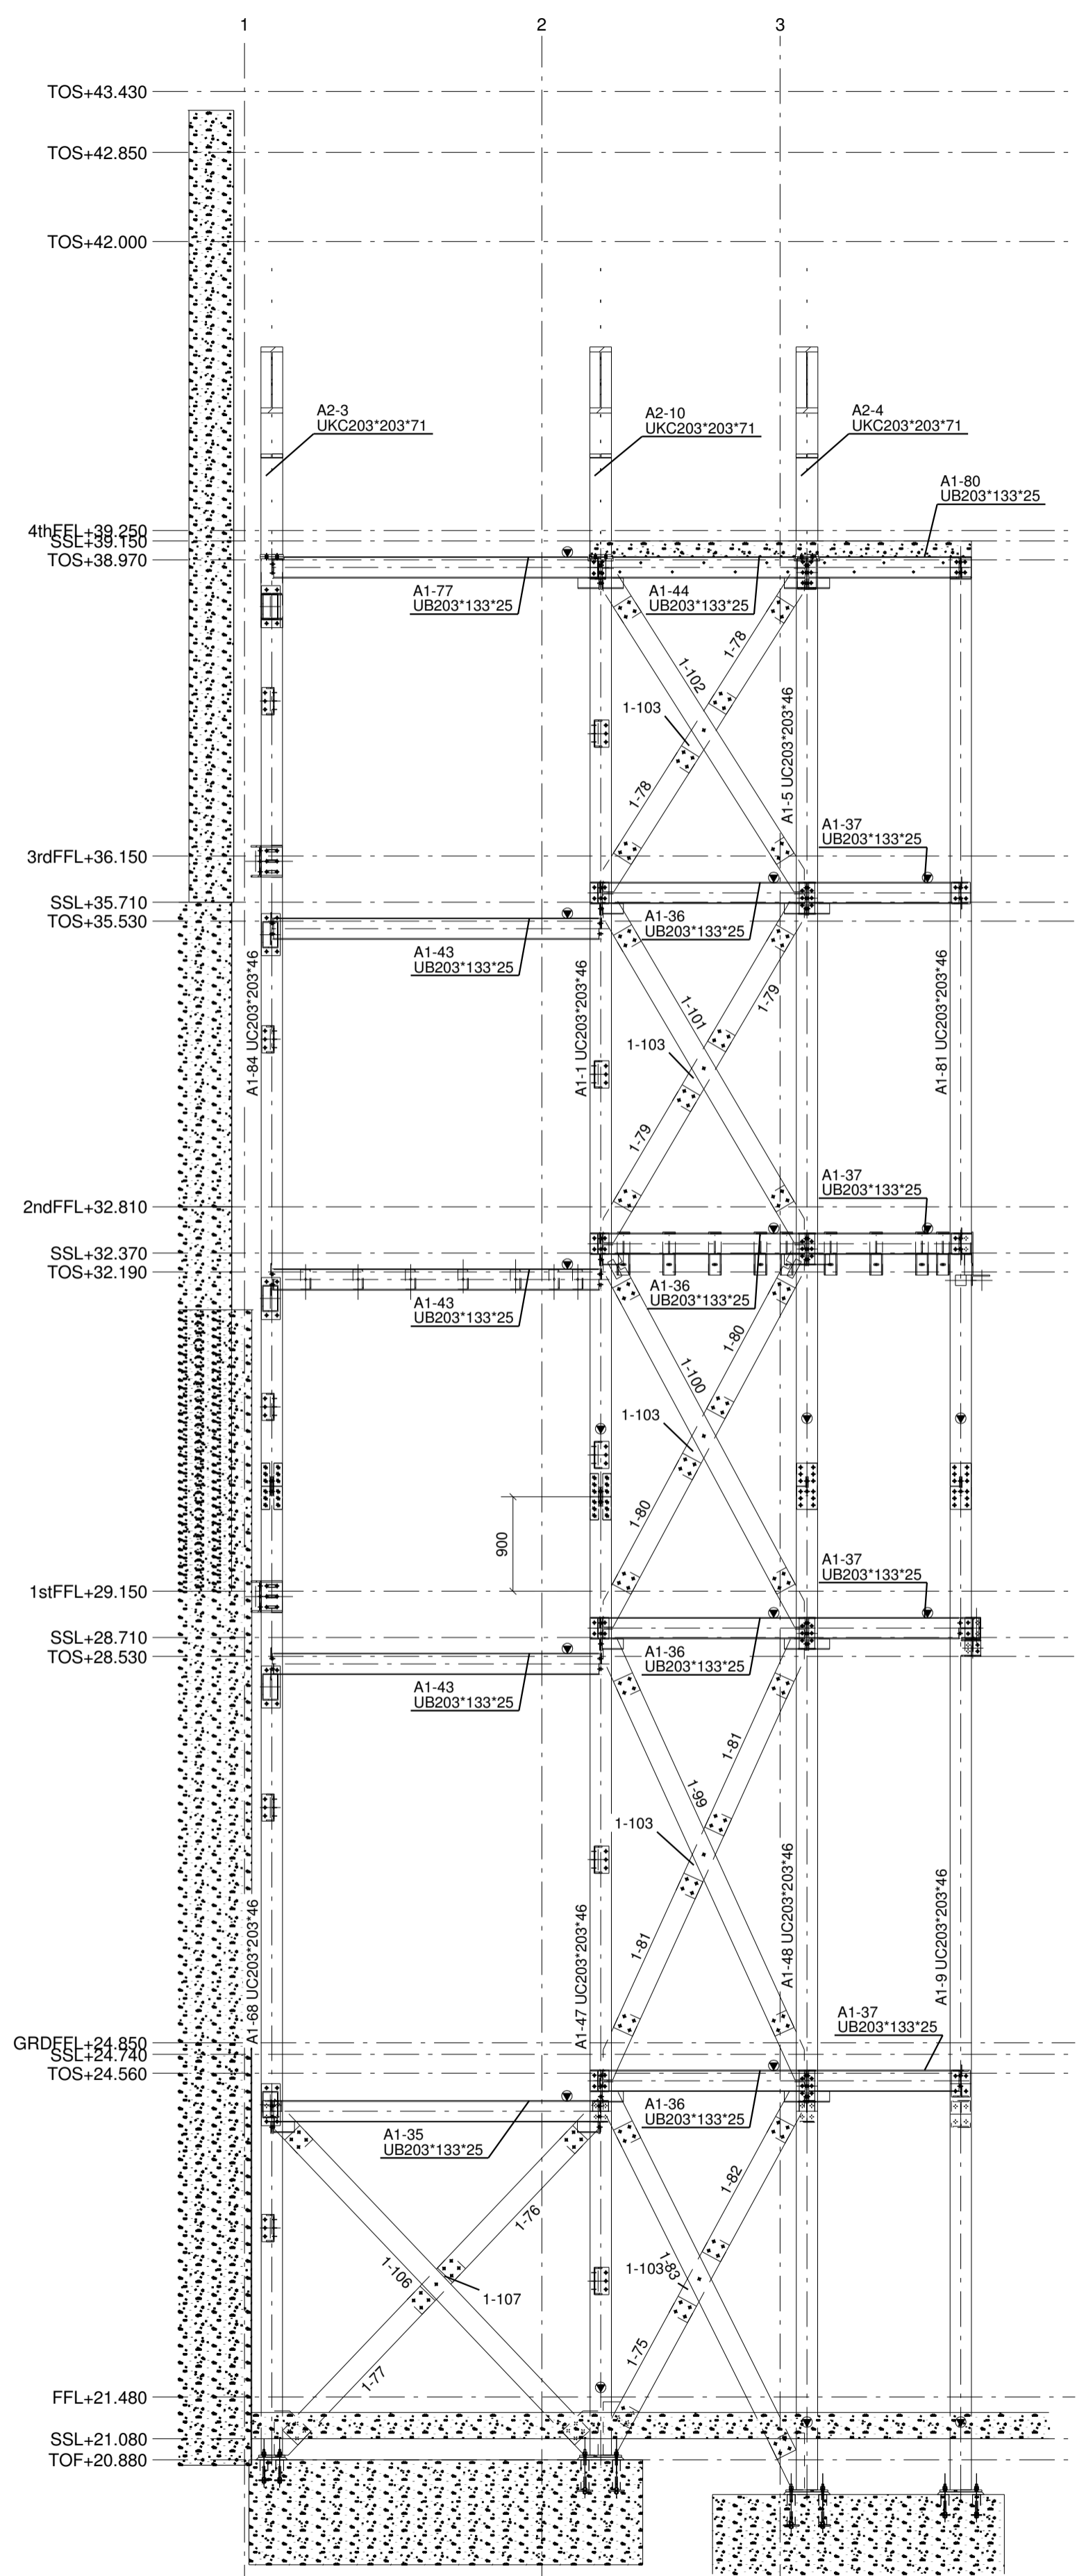


E - E  
GA-06 1:50

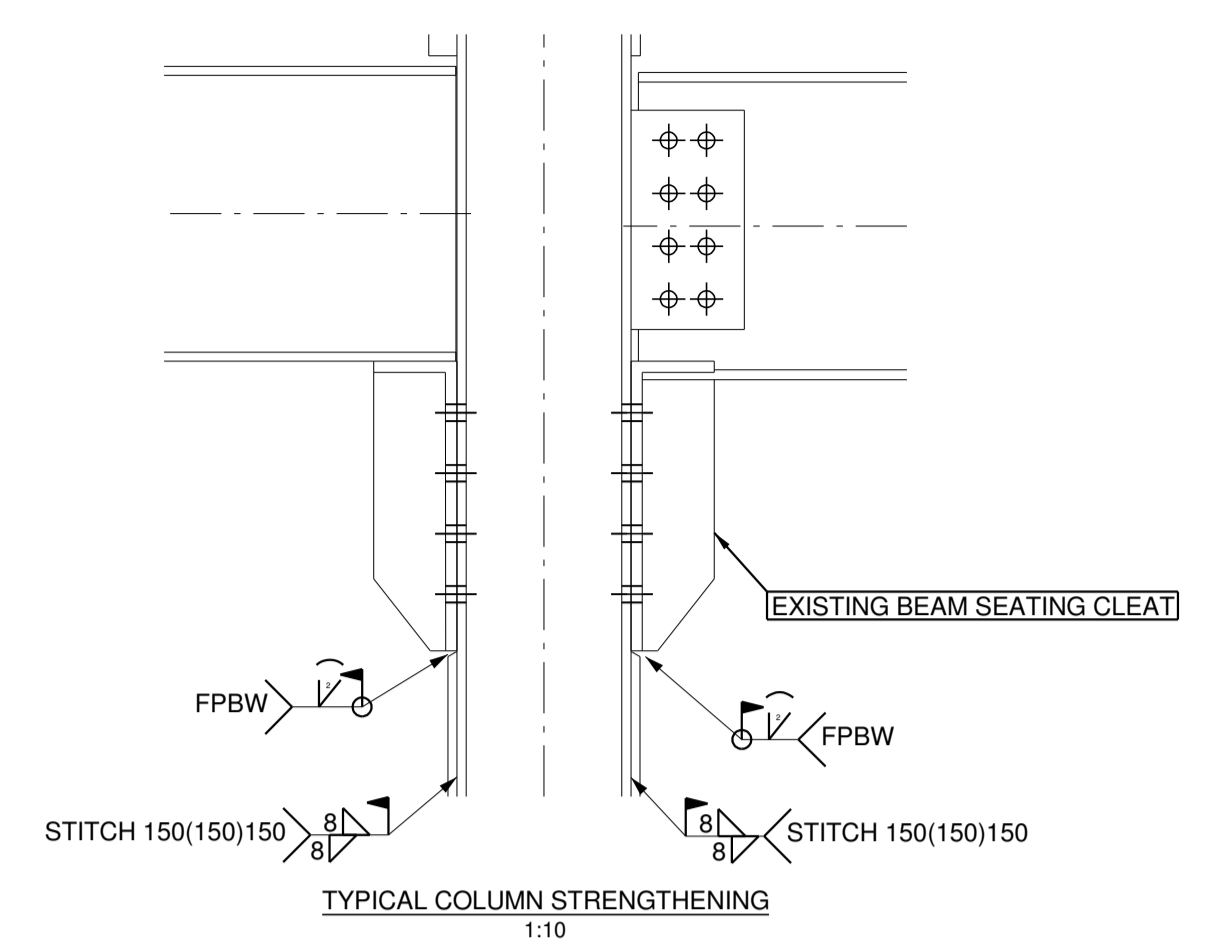

TYPICAL COLUMN STRENGTHENING  
1:10

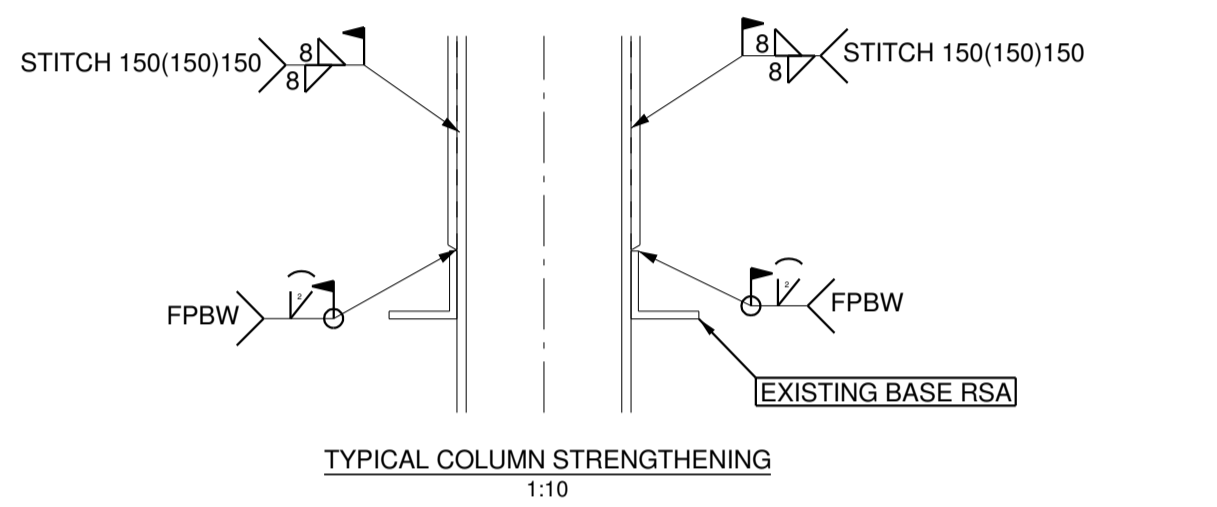

TYPICAL COLUMN STRENGTHENING  
1:10

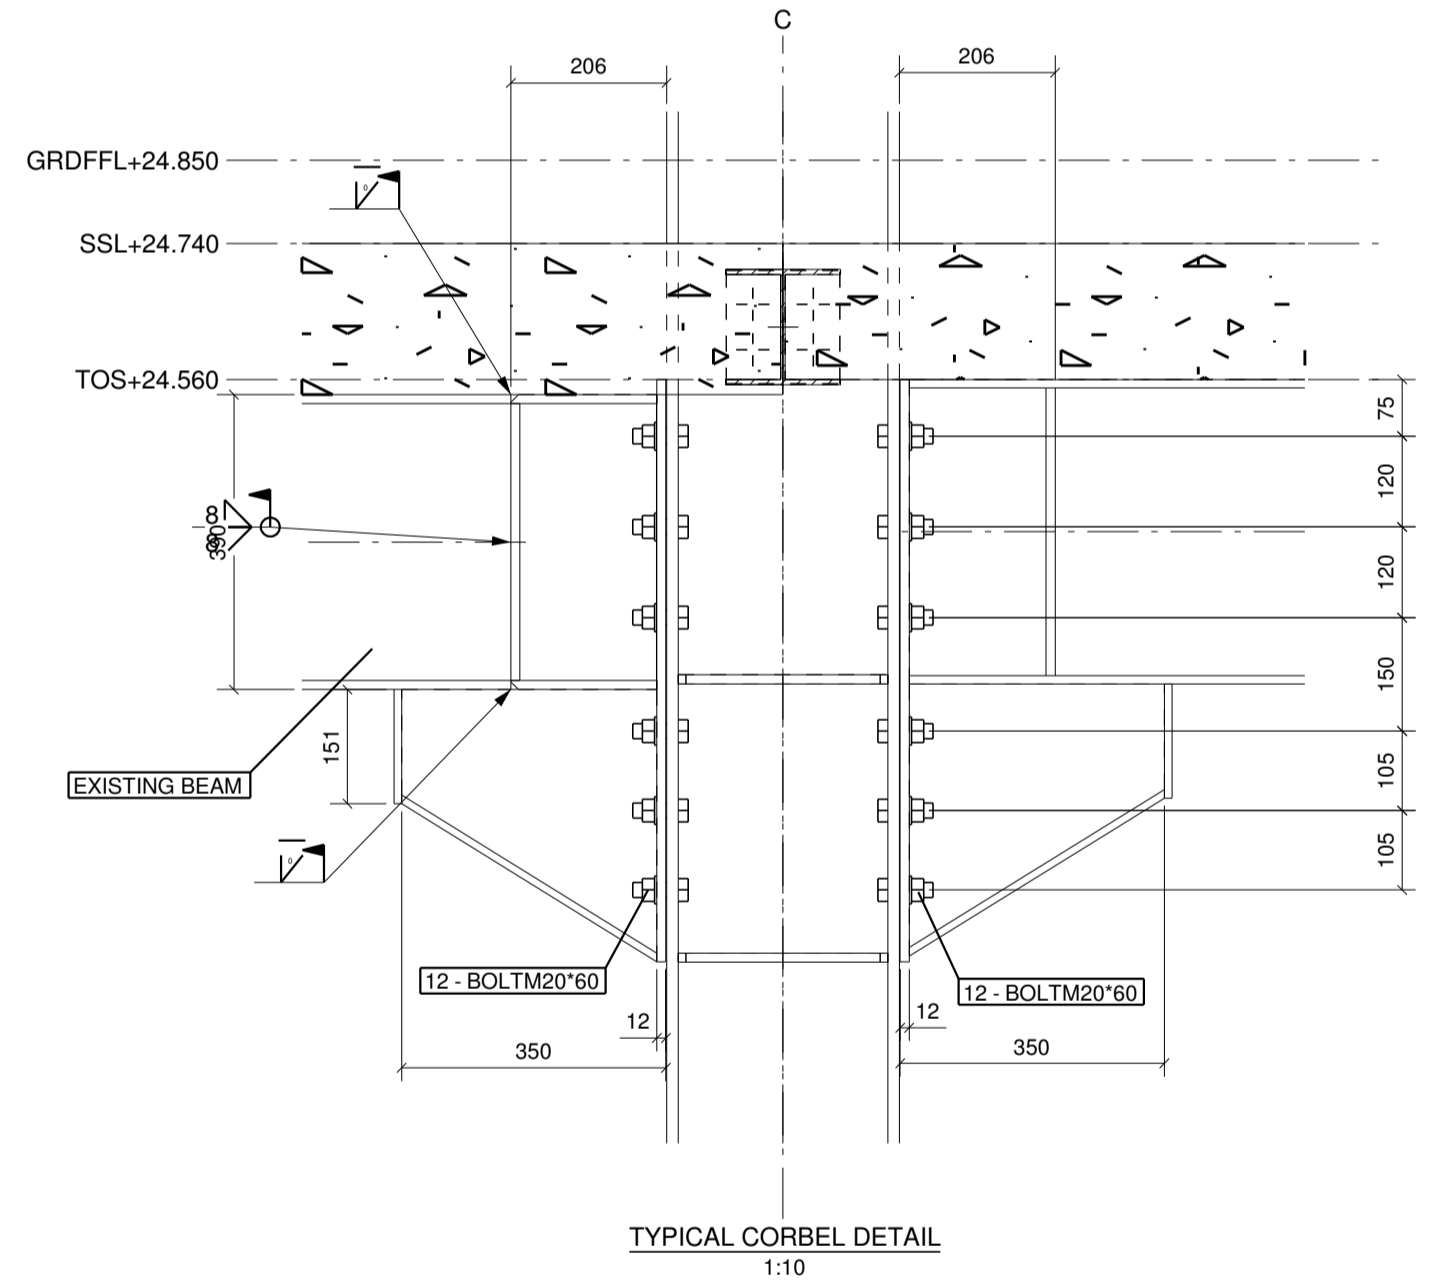

TYPICAL CORBEL DETAIL  
1:10

| REV. MARK | REVISION DESCRIPTION       | REV. DATE |
|-----------|----------------------------|-----------|
| 4         | PART MARKS ADDED           | 06.06.11  |
| 3         | 4TH FFL PART MARKS ADDED   | 25.05.11  |
| 2         | DETAILS ADDED              | 06.04.11  |
| 1         | COLUMN STRENGTHENING ADDED | 25.03.11  |
| 0         | PART MARKS                 | 16.03.11  |

**A C D**  
Architectural Corporate Drafting Ltd  
9 Mailhouse Close  
Whittington  
Oswestry  
Shropshire  
SY11 4NA  
Mobile: 07711 093 578  
Tel/Fax: 01691 654451  
Email: info@a-c-d.co.uk

CLIENT  
**SKANSKA**  
PROJECT DESCRIPTION  
**1-5 POLAND STREET**  
SITE ADDRESS  
**LONDON**  
DRAWING TITLE  
**STRUCTURAL MAIN BUILDING  
SECTIONS & DETAILS**  
GENERAL ARRANGEMENT

SCALE  
1:10 1:50  
DRAWN BY  
**Andy Curran**  
CHECKED BY  
**A. G**  
CONTACT NAME  
**Andrew Gamblen**  
DRAWING CREATION DATE  
**15.03.2011**

|                                      |                                |                      |
|--------------------------------------|--------------------------------|----------------------|
| Material to BS4360. Grade - See Spec | CONTRACT No.<br><b>C/10751</b> | REVISION<br><b>4</b> |
| Surface Finish / Prep: See Spec      |                                |                      |
| Welds: 6mm F.W. Full profile U.S.O.  |                                |                      |
| <b>AS BUILT DRG</b>                  | <b>GA-24</b>                   |                      |