


☑ DENOTES ERECTION MARK LOCATION - FOR ORIENTATION

1. ALL DIMS IN MILLIMETRES UNO
2. RADIUS ALL NOTCHES
3. GENERAL TOLERANCE IS ± 0.5 MM UNO
4. REMOVE ALL BURRS AND SHARP EDGES

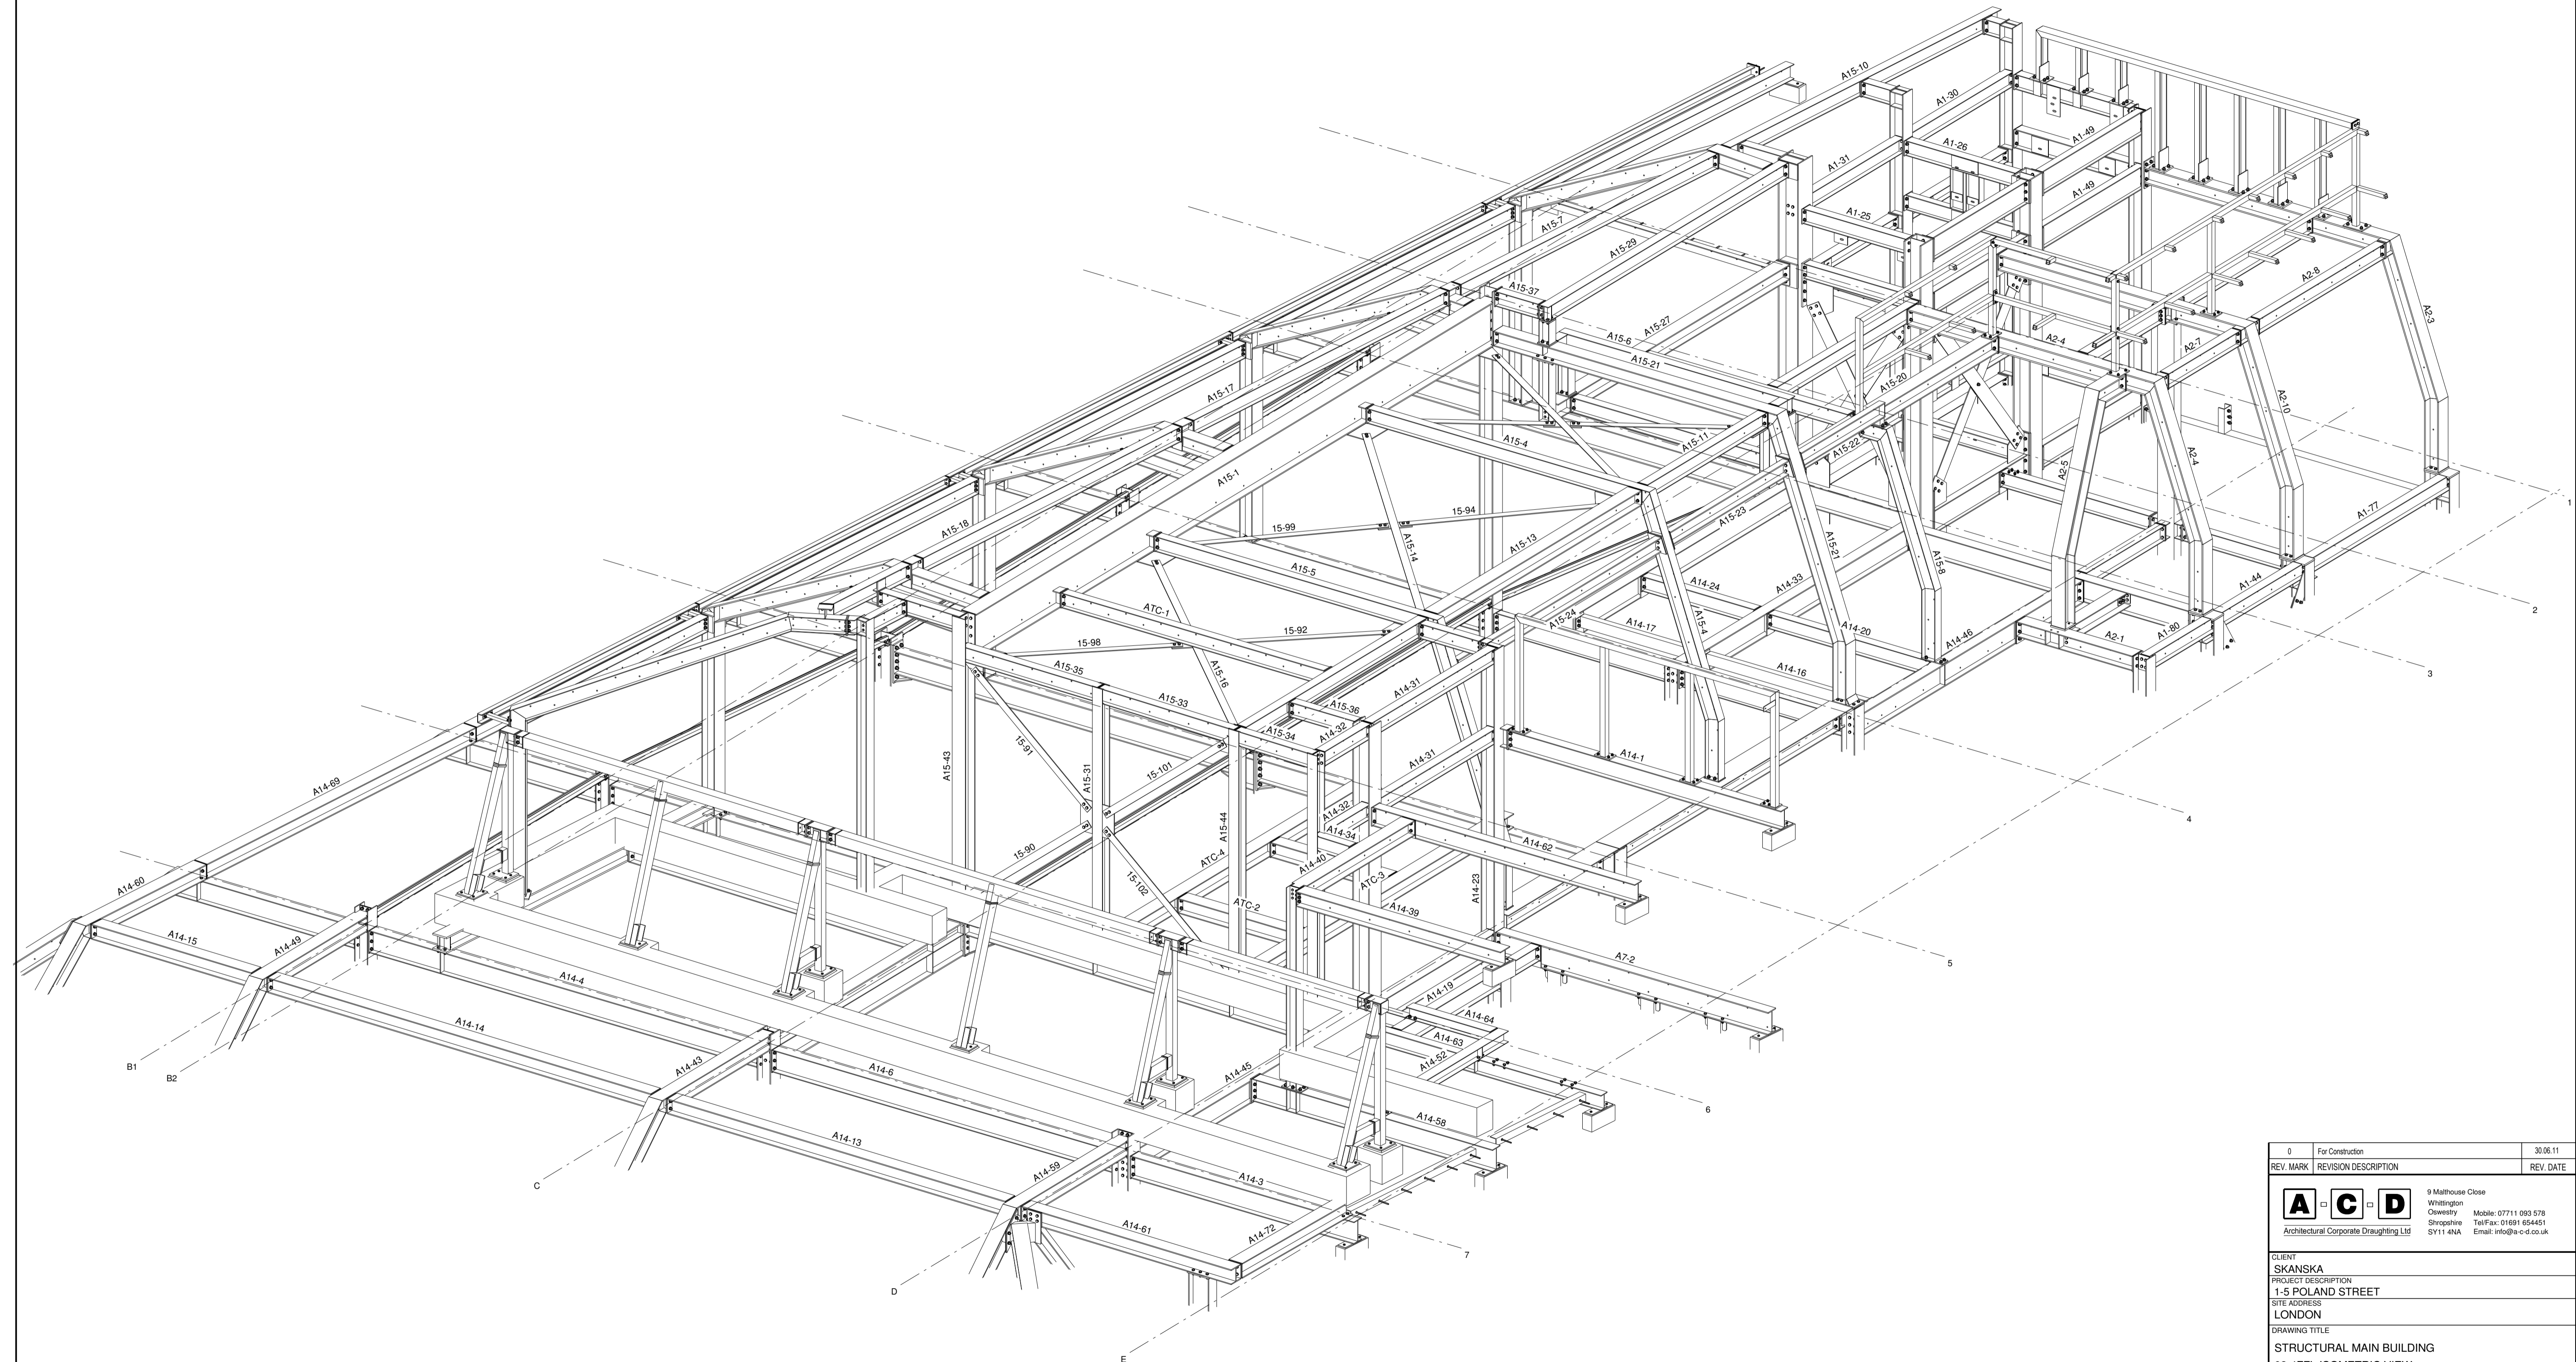

02-4FFL ISOMETRIC VIEW
1:40

0	For Construction	30.06.11
REV. MARK	REVISION DESCRIPTION	REV. DATE



CLIENT
SKANSKA

PROJECT DESCRIPTION
1-5 POLAND STREET

SITE ADDRESS
LONDON

DRAWING TITLE
**STRUCTURAL MAIN BUILDING
02-4FFL ISOMETRIC VIEW**

SCALE
1:40

DRAWN BY Andy Curran	CONTACT NAME Andrew Gamblen
CHECKED BY A. G	DRAWING CREATION DATE 30.06.2011

Material to BS4360. Grade - See Spec	CONTRACT No. C/10751	REVISION 0
Surface Finish / Prep: See Spec		
Welds: 6mm F.W. Full profile U.S.O.		

AS BUILT DRG DRAWING No. **GA-45**