IF IN DOUBT - ASK!
NO COPIES TO BE TAKEN WITHOUT THE PERMISSION OF BECRO ENGINEERING LTD
A1

GENERAL NOTES

HOLES ● BOLTS
CSK HOLES N/S ● F/S

▼ DENOTES ERECTION MARK LOCATION - FOR ORIENTATION

1. ALL DIMS IN MILLIMETRES UNO
2. RADIUS ALL NOTCHES
3. GENERAL TOLERANCE IS $^{0}_{-2}$ MM UNO
4. REMOVE ALL BURRS AND SHARP EDGES

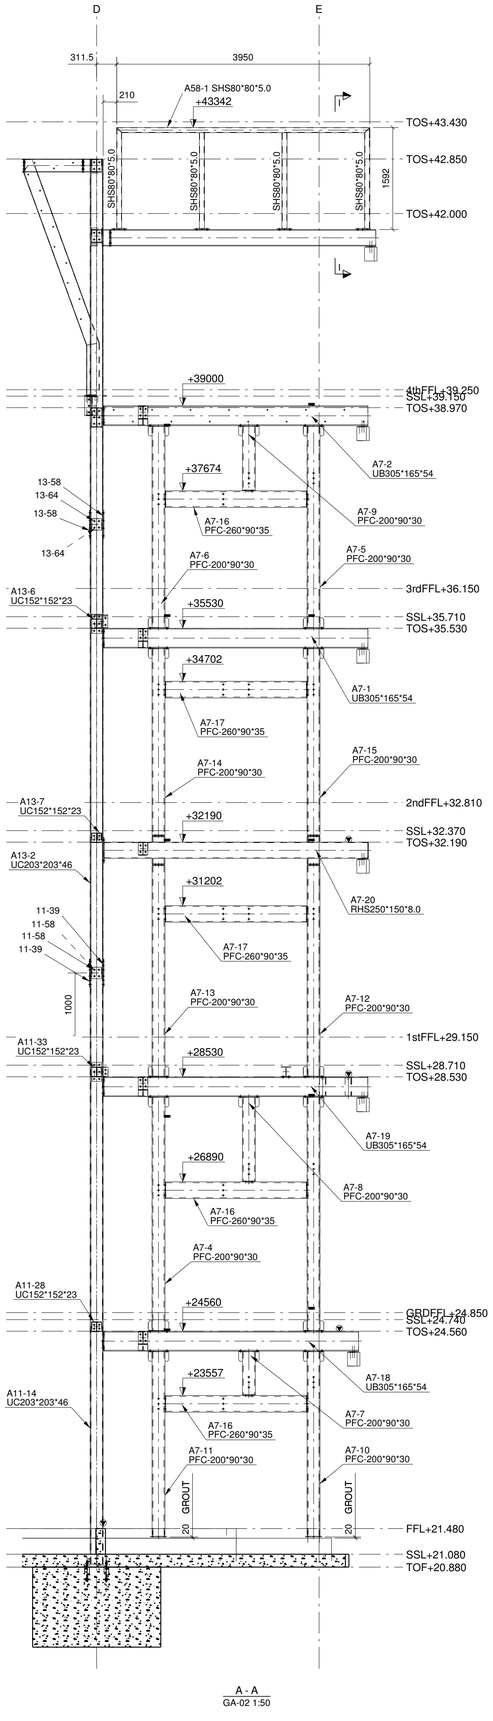

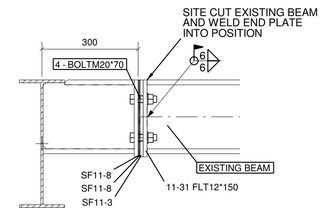

DETAIL 1
GA-20 1:10

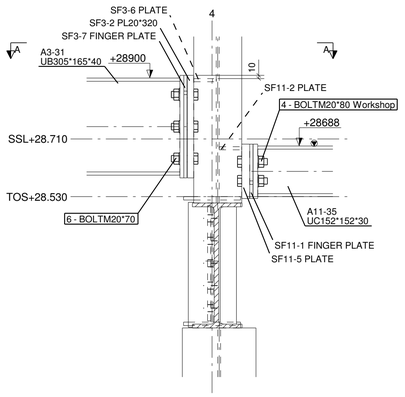

DETAIL 2
GA-20 1:10

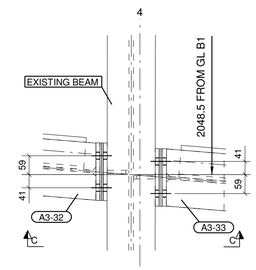

DETAIL 5
GA-02 1:10

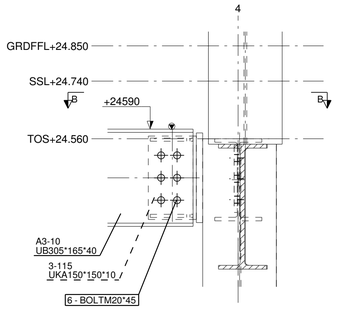

DETAIL 3
GA-20 1:10

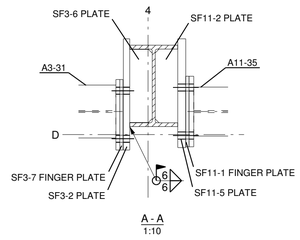

A - A
1:10

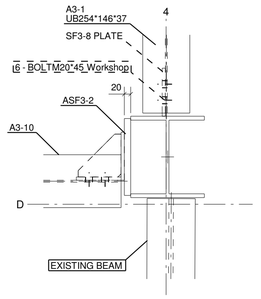

B - B
1:10

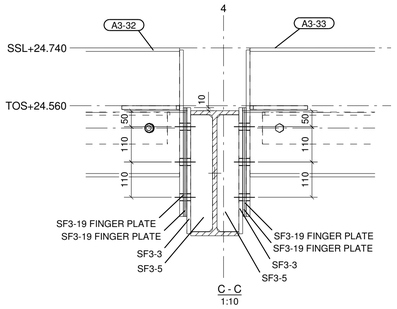

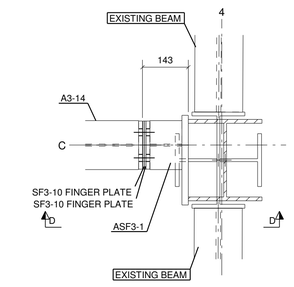

DETAIL 6
GA-02 1:10

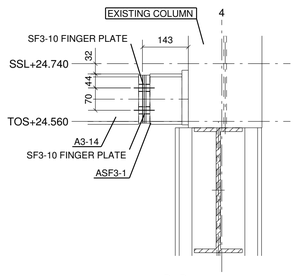

D - D
1:10

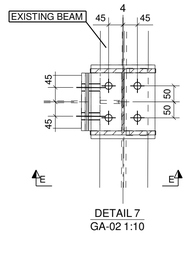

DETAIL 7
GA-02 1:10

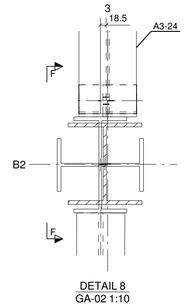

DETAIL 8
GA-02 1:10

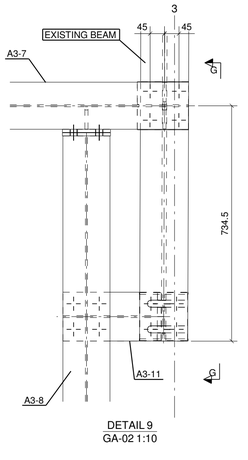

DETAIL 9
GA-02 1:10

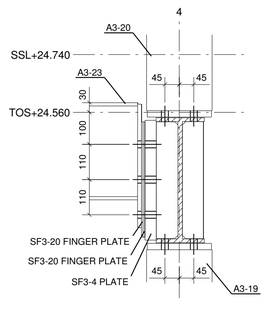

E - E
1:10

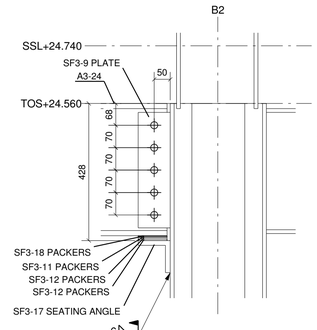

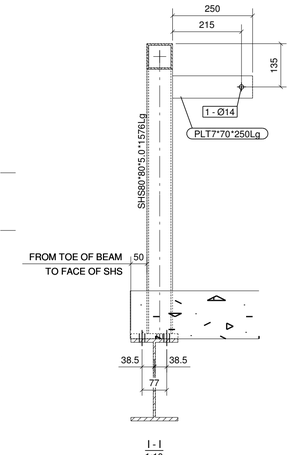

I - I
1:10

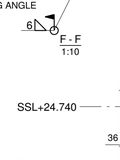

DETAIL 10
GA-11 1:10

H - H
1:10

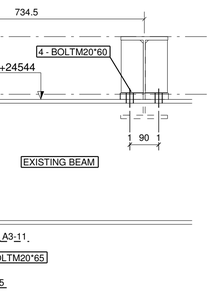

G - G
1:10

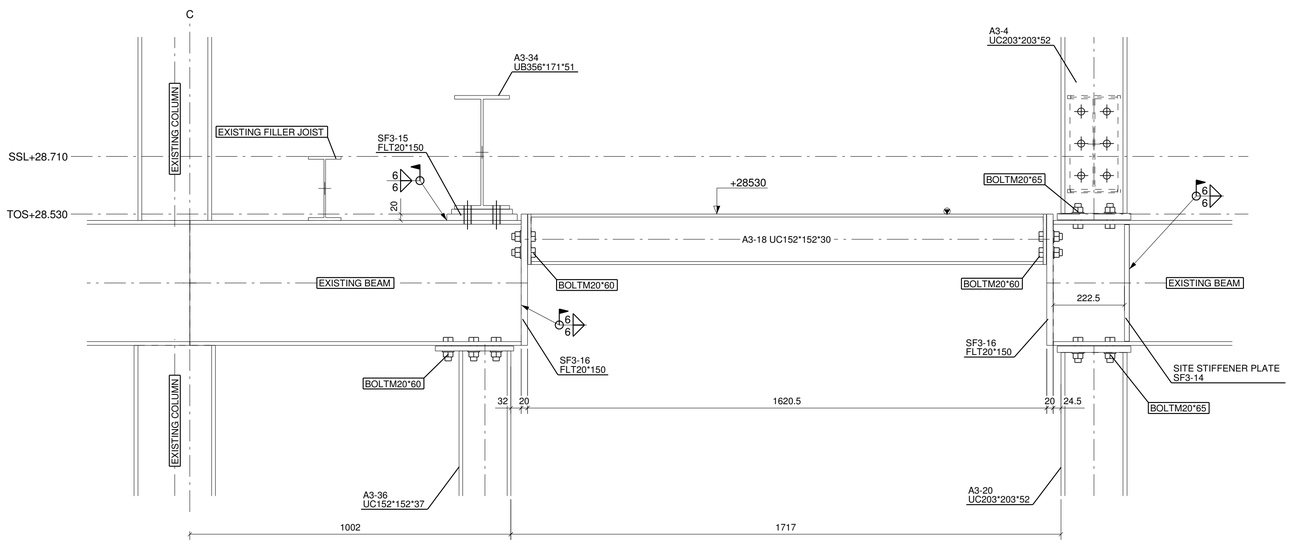

DETAIL 4
GA-11 1:10

REV. MARK	REVISION DESCRIPTION	REV. DATE
4	SECTION A-A - ZINC SUPPORT FRAME	04.08.11
3	4TH FFL PART MARKS ADDED	25.05.11
2	PART MARKS ADDED	08.05.11
1	CONSTRUCTION DETAILS ADDED	13.04.11
0	CONSTRUCTION	06.04.11

A C D
Architectural Corporate Draughting Ltd
9 Malthouse Close
Whittington
Oswestry
Shropshire
SY11 4NA
Mobile: 07711 093 578
Tel/Fax: 01691 654451
Email: info@a-c-d.co.uk

CLIENT
SKANSKA
PROJECT DESCRIPTION
1-5 POLAND STREET
SITE ADDRESS
LONDON
DRAWING TITLE
STRUCTURAL MAIN BUILDING
SECTIONS & DETAILS
GENERAL ARRANGEMENT
SCALE
1:10 1:50
DRAWN BY
Andy Curran
CONTACT NAME
Andrew Gamblen
CHECKED BY
A. G
DRAWING CREATION DATE
07.04.2011
Material to BS4360. Grade - See Spec
Surface Finish / Prep:- See Spec
Welds:- 6mm F.W. Full profile U.S.O.
AS BUILT DRG
ACD REF No:
A-C-D-076-01
CONTRACT No:
C/10751
REVISION
4
DRAWING No
GA-37