IF IN DOUBT - ASK!
NO COPIES TO BE TAKEN WITHOUT THE PERMISSION OF BECRO ENGINEERING LTD
A1

GENERAL NOTES

HOLES ● BOLTS ⊕
CSK HOLES N/S ✶ F/S ✶

▼ DENOTES ERECTION MARK LOCATION - FOR ORIENTATION

1. ALL DIMS IN MILLIMETRES UNO
2. RADIUS ALL NOTCHES
3. GENERAL TOLERANCE IS $^{0}_{3}$ MM UNO
4. REMOVE ALL BURRS AND SHARP EDGES

LIFT SHAFT SECONDARY STEELWORK
PREFIX PART No 52-
PREFIX ASSEMBLY No A52-

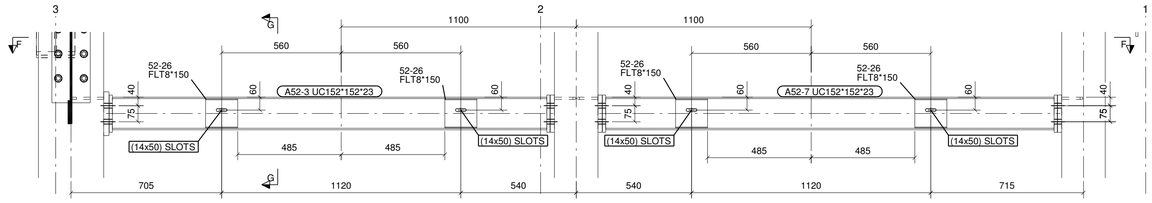

DETAIL 1
GA-40 1:15

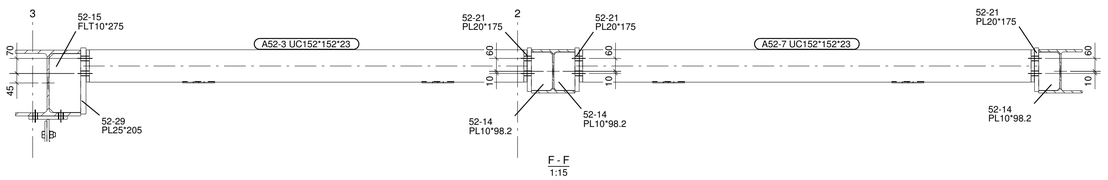

F - F
1:15

G - G
1:15

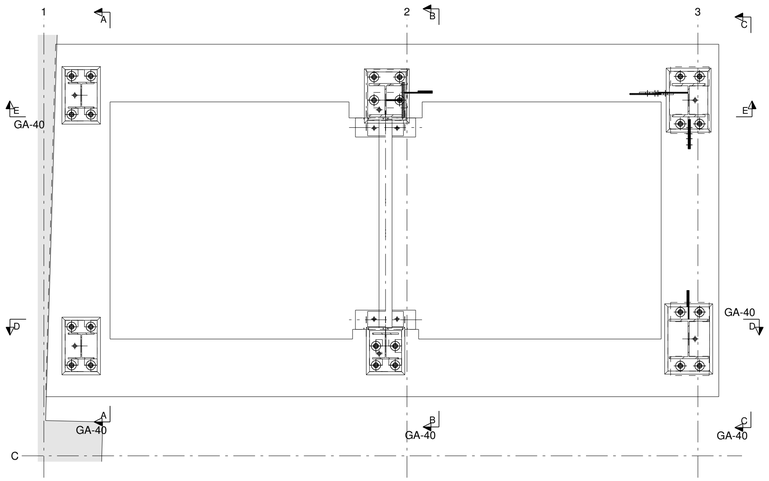

Plan SSL+21.080
1:25

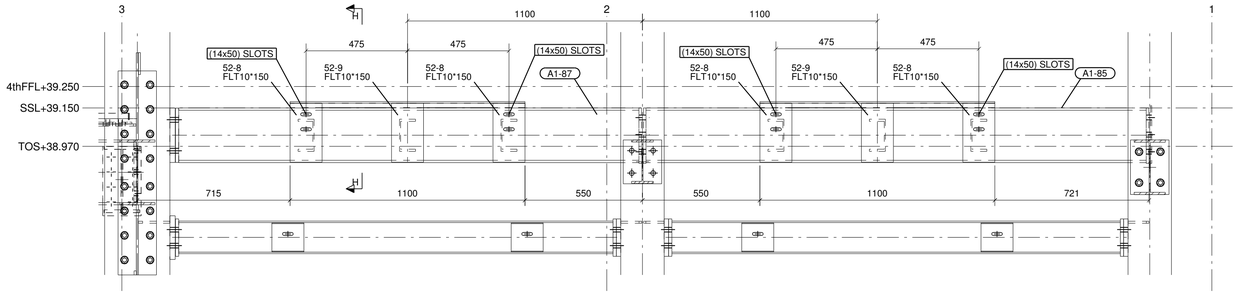

DETAIL 2
GA-40 1:15

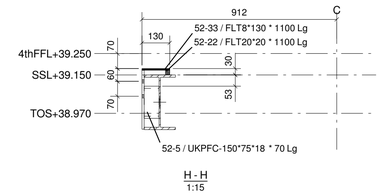

H - H
1:15

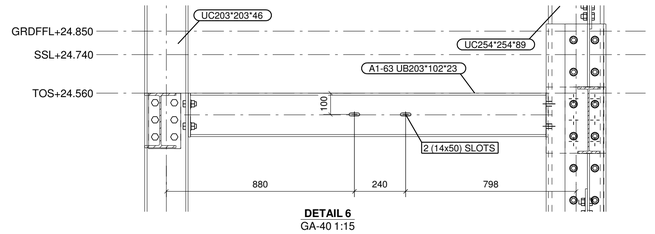

DETAIL 6
GA-40 1:15

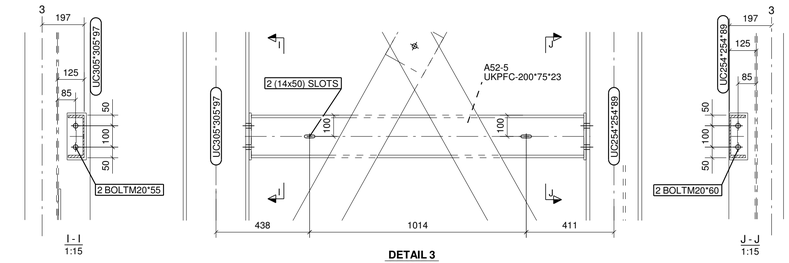

DETAIL 3
GA-40 1:15

I - I
1:15

J - J
1:15

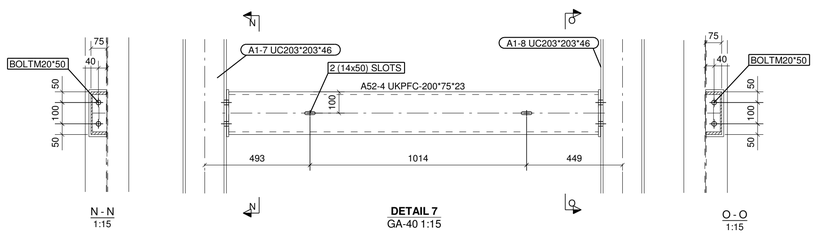

DETAIL 7
GA-40 1:15

N - N
1:15

O - O
1:15

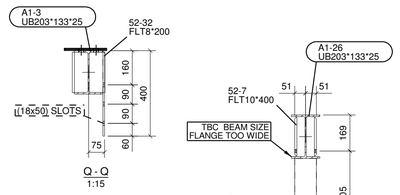

Q - Q
1:15

S - S
1:15

R - R
1:15

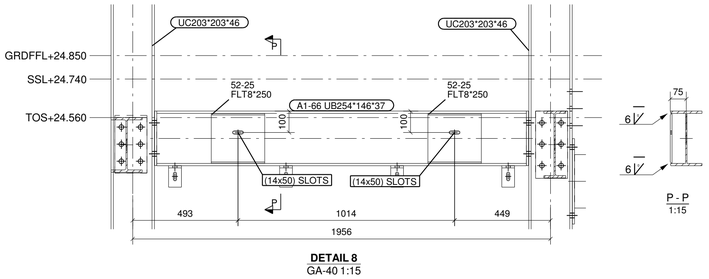

DETAIL 8
GA-40 1:15

P - P
1:15

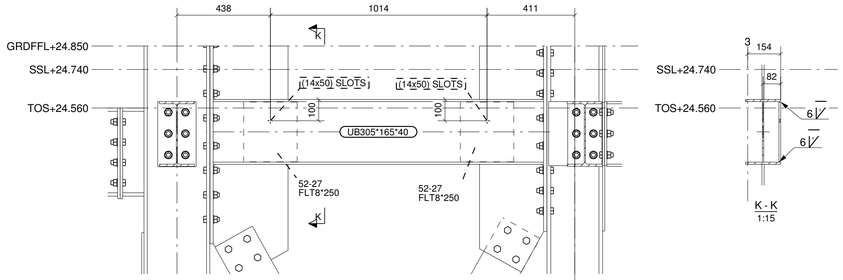

K - K
1:15

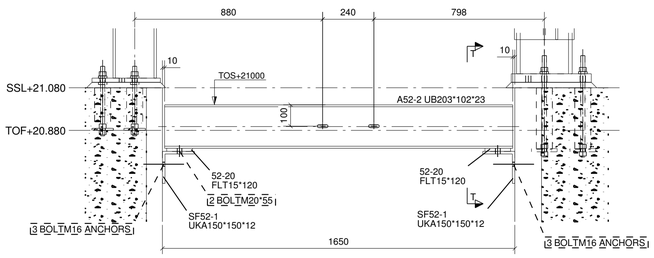

DETAIL 9
GA-40 1:15

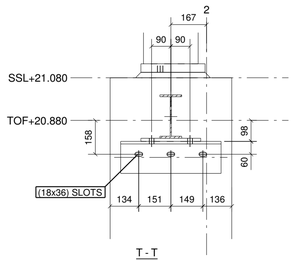

T - T
1:15

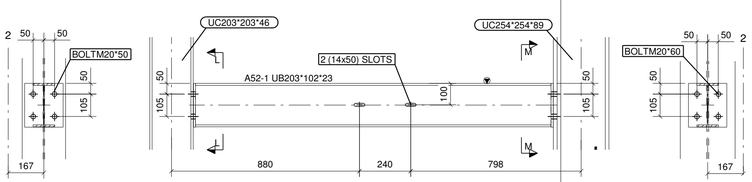

L - L
1:15

M - M
1:15

1	REVISED TO COMMENTS / CONSTRUCTION ISSUE	31.05.11
0	FOR APPROVAL / COMMENTS	14.05.11
REV. MARK	REVISION DESCRIPTION	REV. DATE

A C D
Architectural Corporate Draughting Ltd
9 Malthouse Close
Whittington
Oswestry
Shropshire
SY11 4NA
Mobile: 07711 093 578
Tel/Fax: 01691 654451
Email: info@a-c-d.co.uk

CLIENT
SKANSKA

PROJECT DESCRIPTION
1-5 POLAND STREET

SITE ADDRESS
LONDON

DRAWING TITLE
STRUCTURAL MAIN BUILDING
LIFT SHAFT SECONDARY STEELWORK

SECTIONS & DETAILS

SCALE
1:15 1:25

DRAWN BY
Andy Curran

CONTACT NAME
Andrew Gamblen

CHECKED BY
A. G

DRAWING CREATION DATE
13.05.2011

Material to BS4360. Grade - See Spec
Surface Finish / Prep:- See Spec
Welds:- 6mm F.W. Full profile U.S.O.

AS BUILT DRG

ACD REF No:
A-C-D-076-01

CONTRACT No:
C/10751

REVISION
1

DRAWING No
GA-41